

SEE 4-00-010-B

DR.


LAKE

DR.

60

S

54 - C

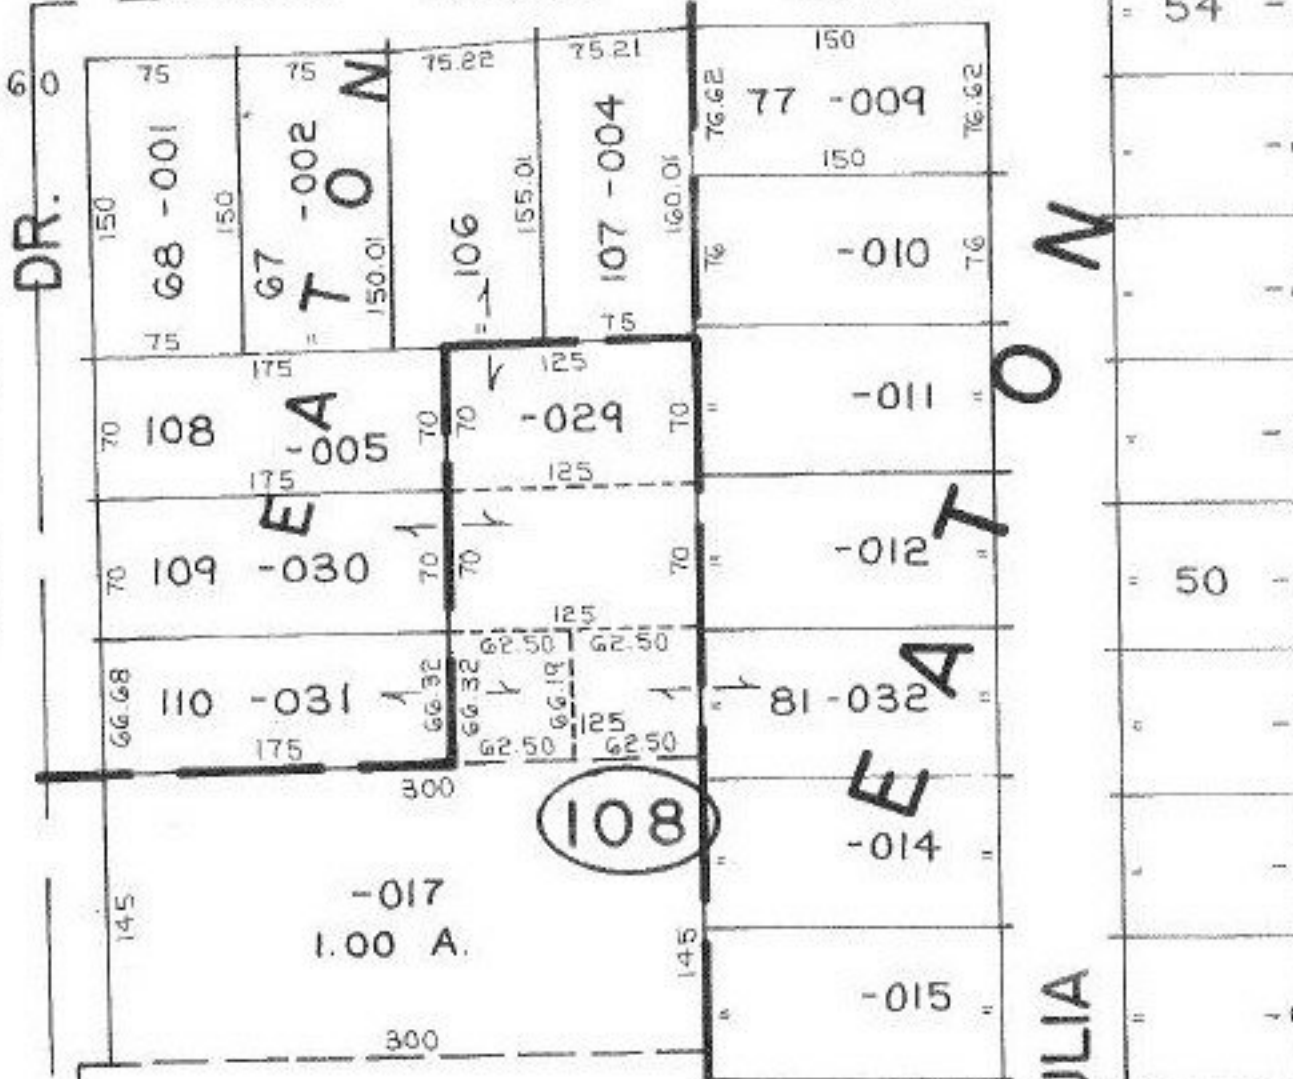

108

JULIA

Pt. 04-00-010-106-030

Pt. 6.23 A. 6.12 A.

#19507

APPROVED R-02

LORAIN CO. MAINT. DEPT.

DATE 4-20-90

PAGE 4-00-010-C

BY CAROLYN FRANKS

VOID AFTER 19507

EATON

CARLEEN

PT. INST 1333/824

SUB

810-010

EATON

04-00-010-106

16-006

34-008

009