


-022 1411.50
 75 A. 1411.30
 .20
~~1411.10~~

41.55 A
 4.00 A
~~41.55 A~~
 722
~~750~~
 472

Pt. -026
 Pt. 41.55A

Pt. -009
 45.55 A.

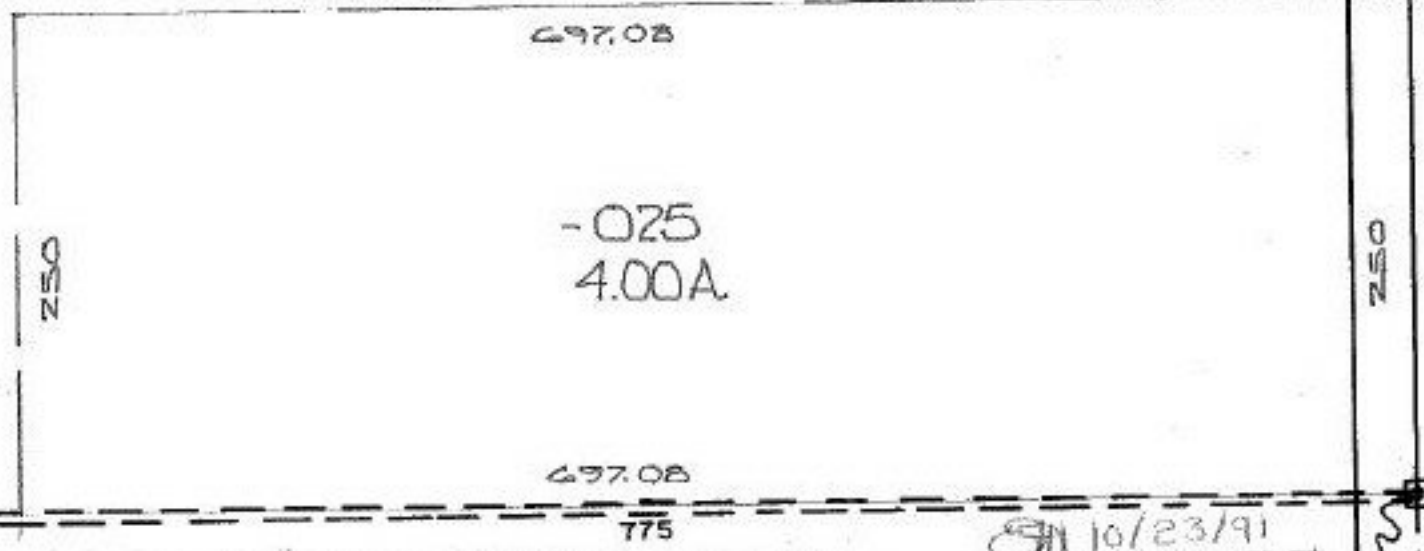

09-00-011-000- PRIOR INST. O.R.126/797
 SURVEYED BY: JOHN POZYMAK REG. SURVEYOR
 C=1: INF.

SM 10/23/91
 # 19528

APPROVED
 LORAIN CO.
 MAP DEPT.

DATE 8-26-91

PAGE 9-00-011B

BY CAROLYN
 FRANCIS

BOOK # 19528

- 016
 6.25 A.

QUARRY RD.

FROM INTERSECTION CENTERLINES
 TO 1411.50

351.50

351.50

1411.50