


SEE

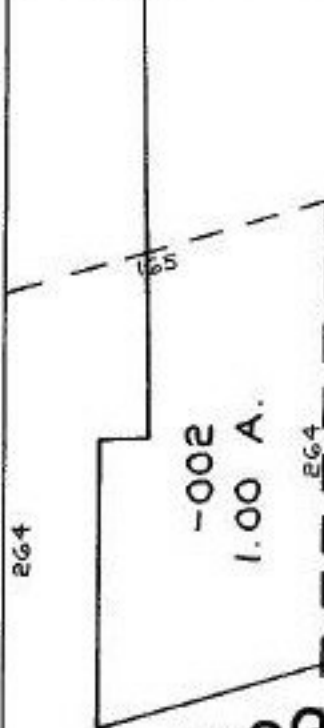

-002  
1.00 A.

#19550-A

-023  
~~3.00 A.~~  
2.88 A.

ACRE CORRECTION PER SURVEY  
 GARY E. PENFOUND 11/20/88  
 PRIOR INST. REF. DU 957/633

-006  
8.05 A.

264

495

495

MOU.

264

165

AKA WHITTLE  
746.80

COOPER FOSTER PARK

746.80

11/8/91

#19550-A

ACREAGE CORR.

|                                     |
|-------------------------------------|
| APPROVED<br>LORAIN CO.<br>MAP DEPT. |
| DATE 9/20/91                        |
| PAGE 1-00-026-A                     |
| BY T. McVain                        |
| VOID<br>AFTER 19550-A               |