


SE

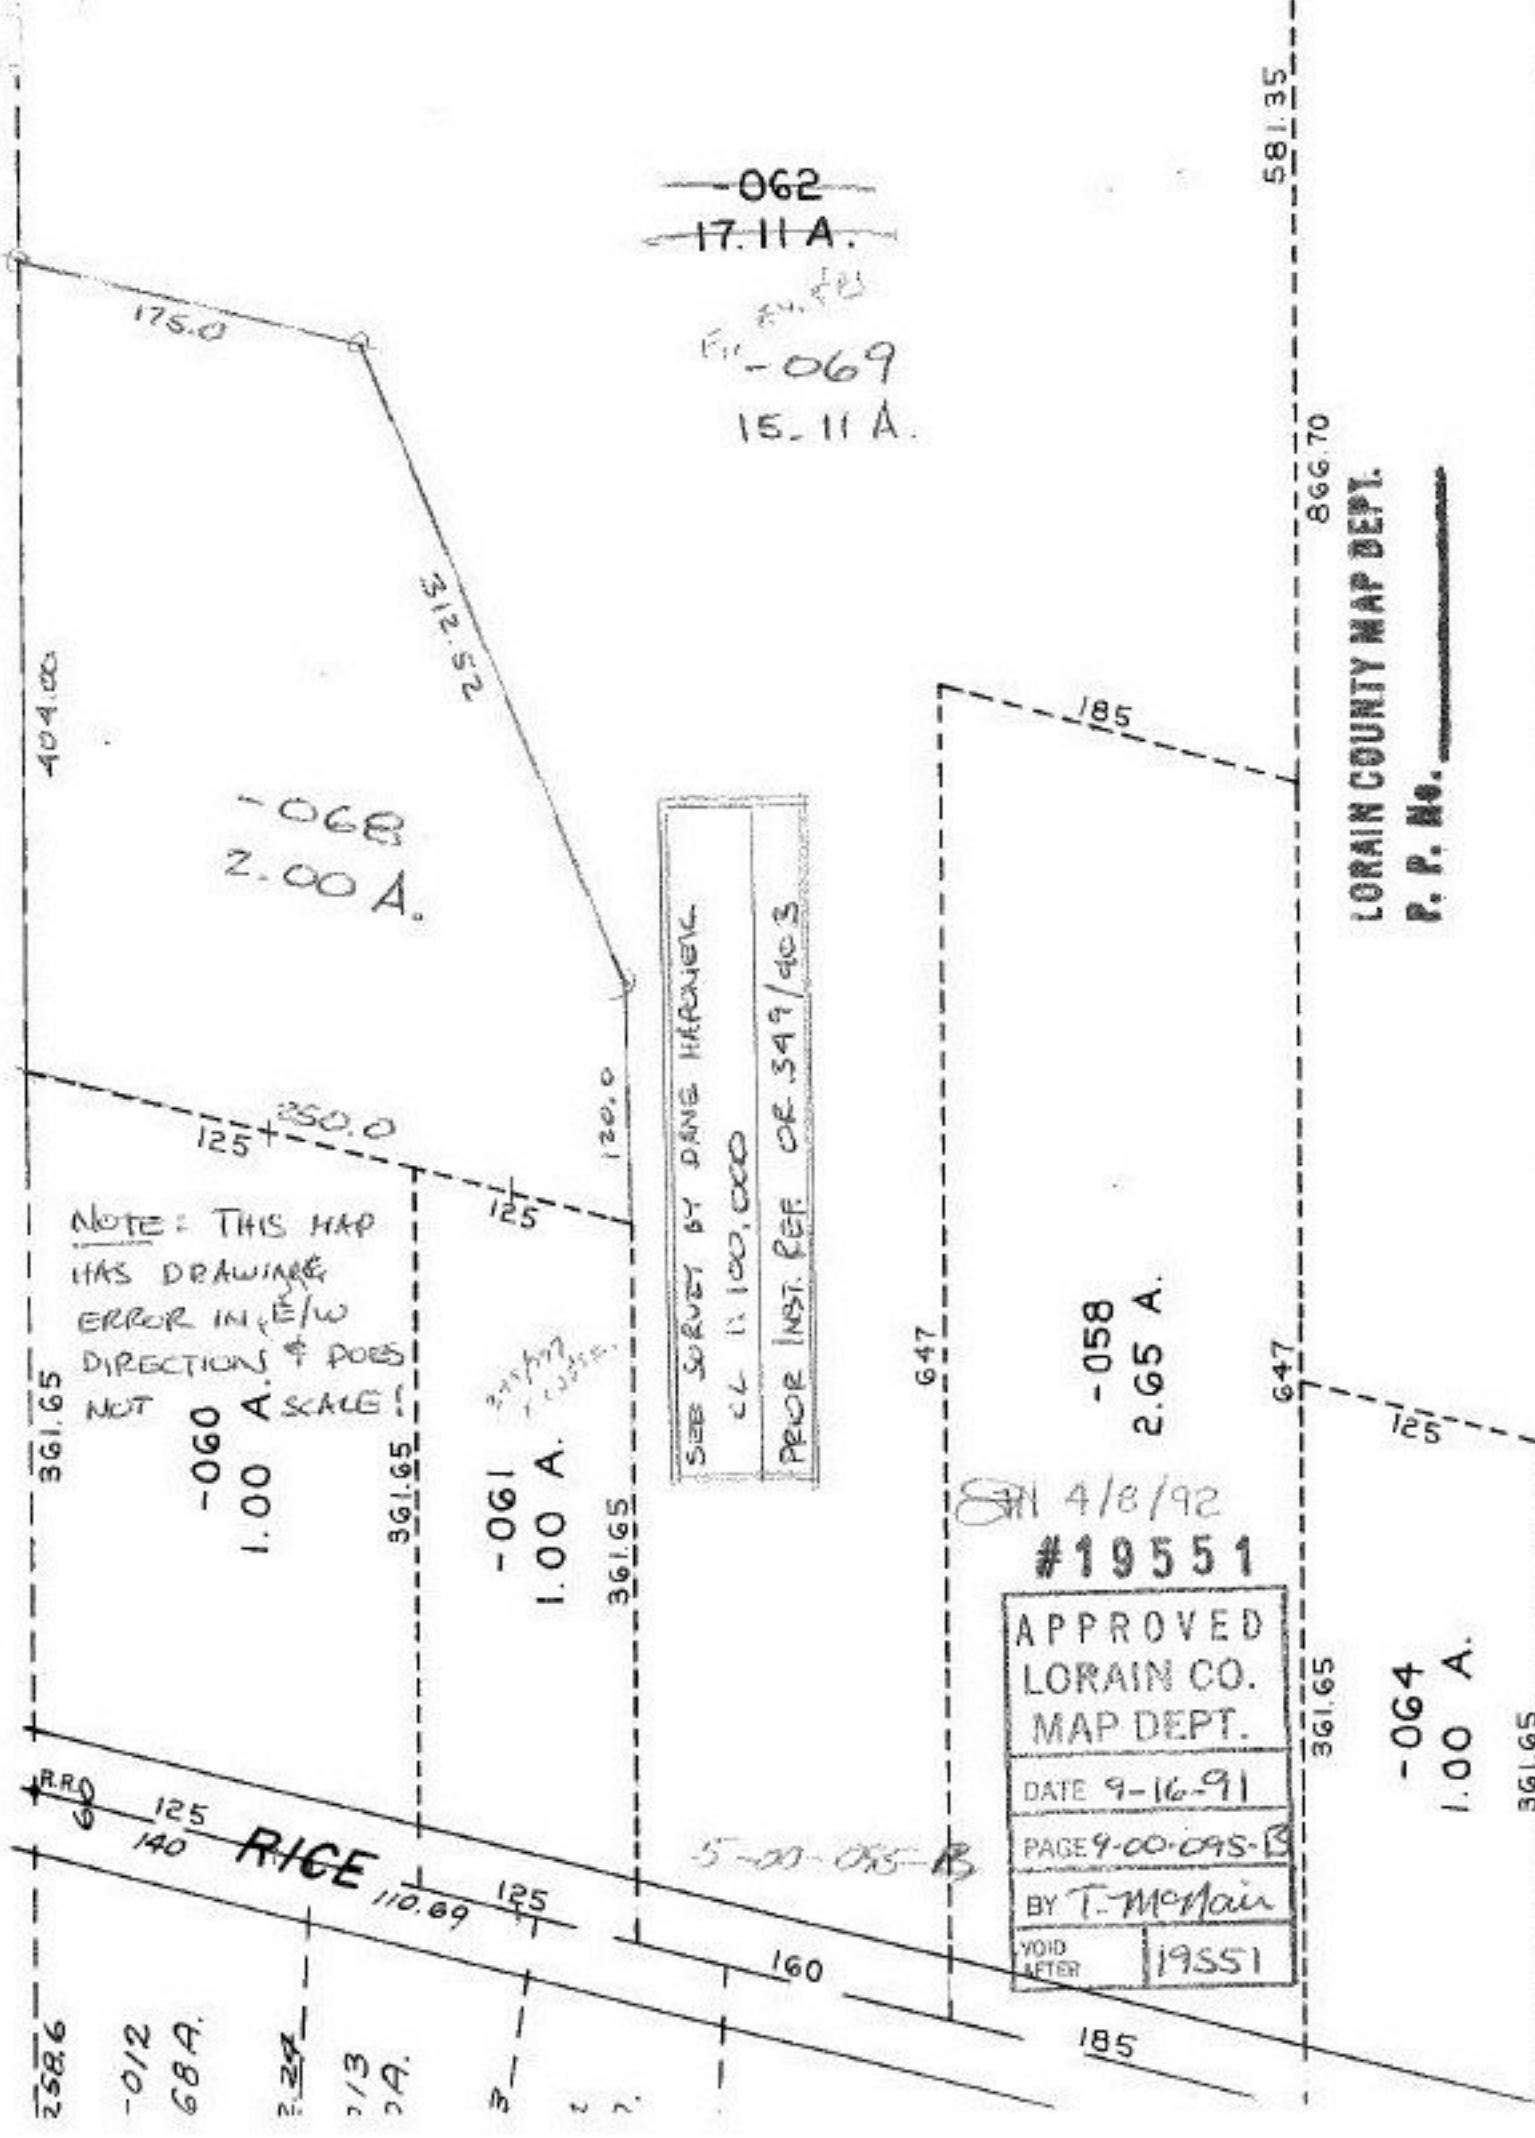

~~-062~~
~~17.11 A.~~
 -069
 15.11 A.

-068
 2.00 A.

SEE SURVEY BY DANE HARWING
 CL 11, 100, 000
 PRIOR INST. REF. OR. 349/403

NOTE: THIS MAP
 HAS DRAWING
 ERROR IN E/W
 DIRECTION & DOES
 NOT SCALE!

-060
 1.00 A.

-061
 1.00 A.

-058
 2.65 A.

4/8/92
 #19551
 APPROVED
 LORAIN CO.
 MAP DEPT.
 DATE 9-16-91
 PAGE 9-00-095-B
 BY T. McMain
 VOID AFTER 19551

-064
 1.00 A.

RRD
 125
 140
RICE
 110.89
 125
 160
 185

581.35
 866.70
 LORAIN COUNTY MAP DEPT.
 P. P. No. _____