


SEE 10-00-001-F

OLD MAP  
CARLISLE  
Pg 6-E

120.81  
70  
56.80  
46.0  
19.5  
46.5

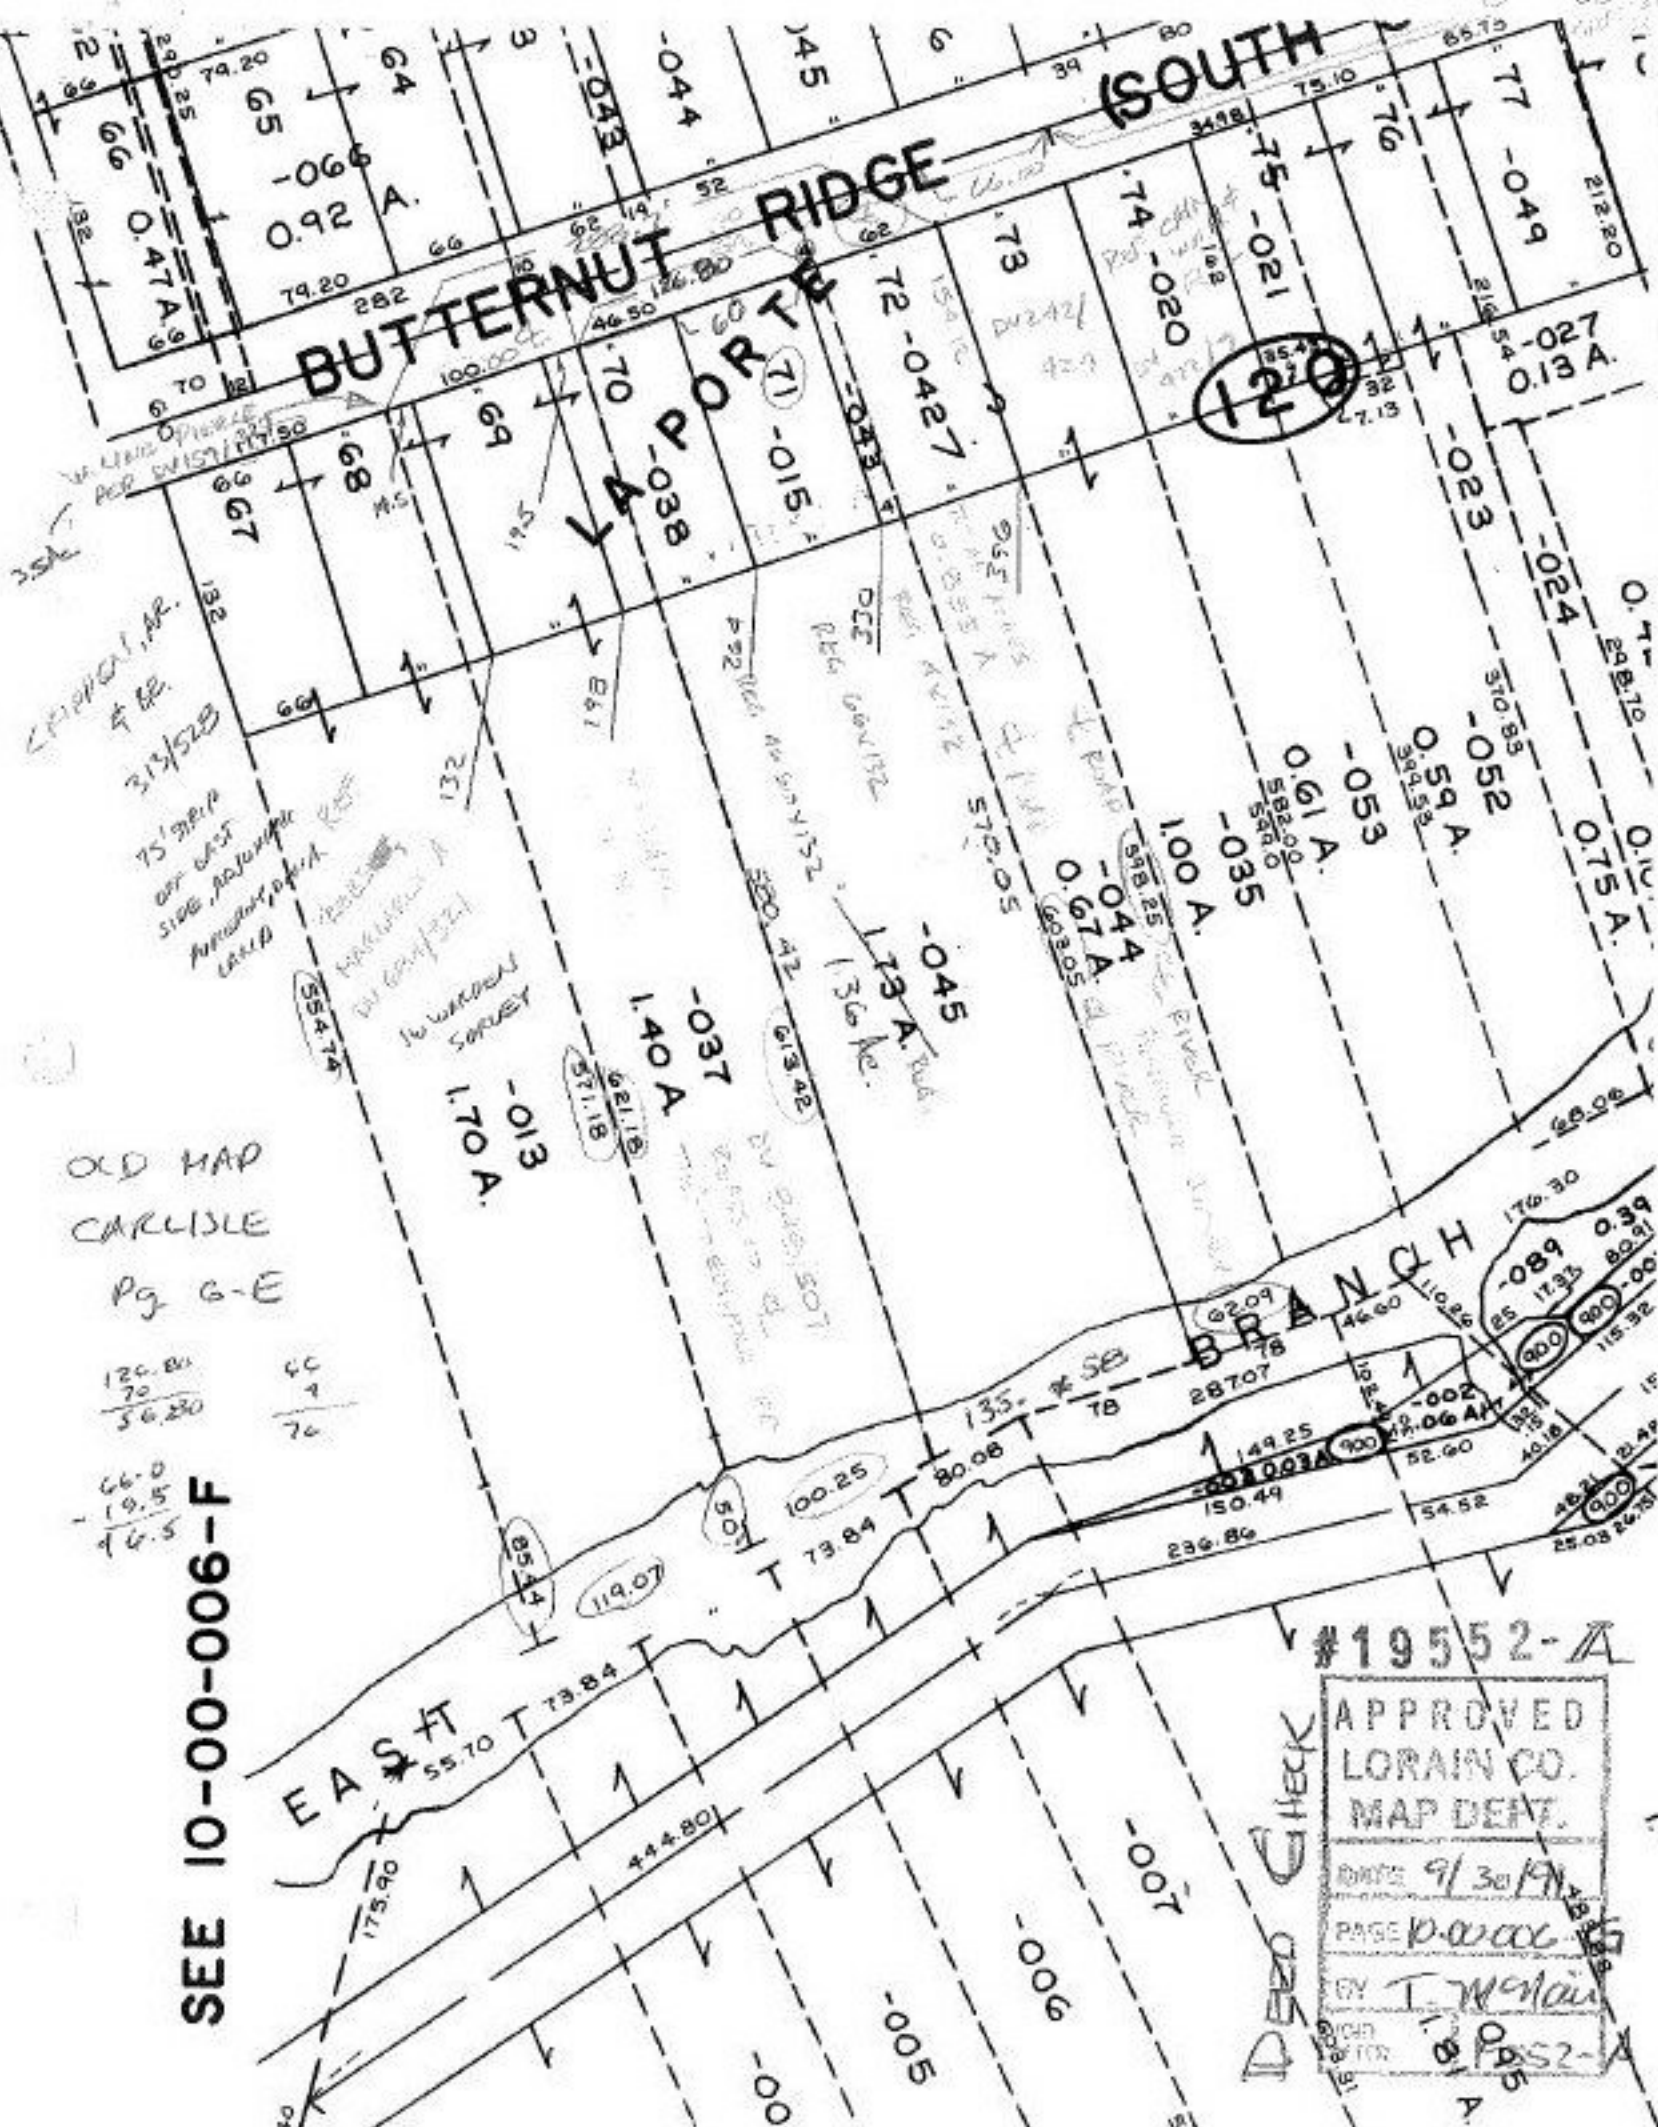

#19552-A

DEED CHECK

APPROVED  
LORAIN CO.  
MAP DEPT.

DATE 9/30/91

PAGE 10-0000

BY T. McNeil

10-0000

10-0000