


1.00 A
0.59 A
0.41 A

SEE 3 - 00 - 008 - A

54 / W D
RD.
293.12

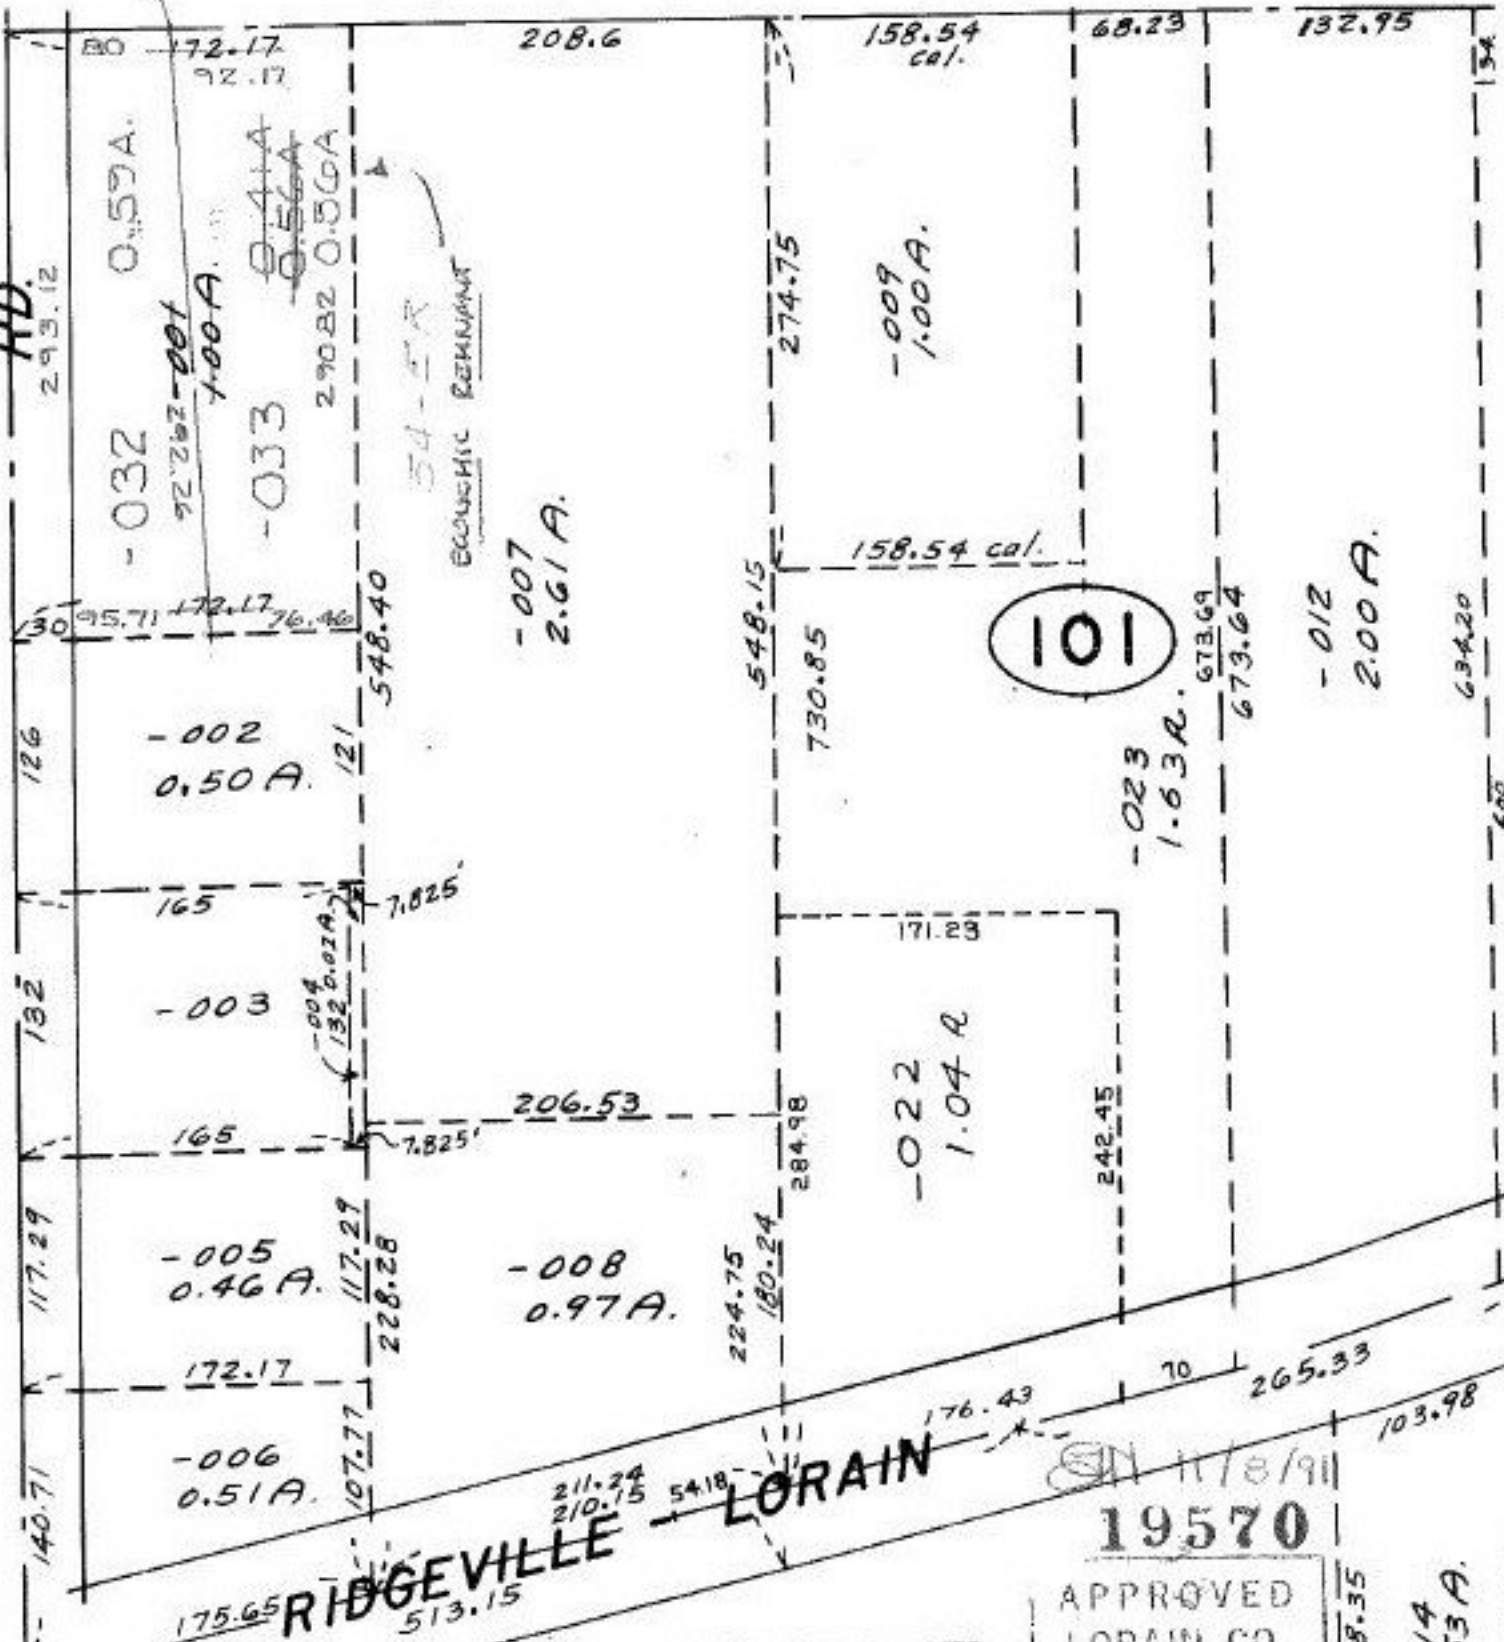

STATE OF OHIO R/W PLANS ST. RT. 611-7.98
 03-00-007-101- PRIOR INST. 808/678,681,683
 @ 1:125,000 @ 200,000

APPROVED
 LORAIN CO.
 MAP DEPT.
 DATE 10-22-91
 PAGE 3-00-007-A
 CALDWIN
 BY FRANCIS 8/3/91
 VOID AFTER 19570

-001
6.67 A.

-014
0.53 A.

105.06