

53-A


HENDERSON DR. FROM INTERSECTION CENTER MISSOURI AVE. SOUTH LINE COLORADO AVE.

2388.70
2186.85
1725.00

① ② ③

FRONTAGE OF ① ② ③ GUES TO S. LINE COLORADO AVE.

COLORADO AVE.

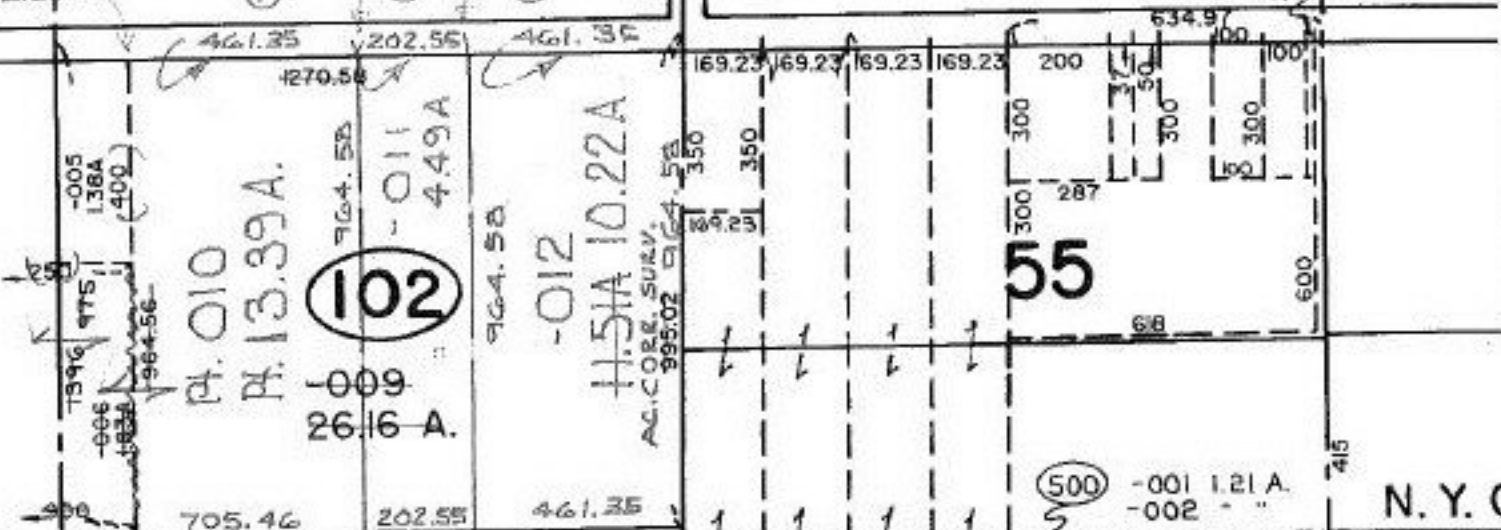

Y. C.

500

R. R.

N. Y. C.

1872

-053-108-028 1.40 A
-054-102-006 1.83 A
-009 20.16 A
29.39 A

29.39 A 16.00 A
13.39 A 4.49 A
16.00 A 11.51 A
AC. CORR. SURV. 10.22 A

10/31/91
19573

APPROVED
LORAIN CO.
MAP DEPT.

DATE 287 29 24-91
BY FRANCIS
VOID AFTER # 19573

Pt. -013
Pt. 47.62 A.

54
102


121

Pt. -017
Pt. 76.18 A.

03-07-053-108- 03-07-054-102
SURVEYED BY: WILLIAM D. # 457
REG. SURV. LANDREG=1:
LAKE INC. ENGRS & SURVEYORS

50 PRIOR INST. 978/304
1000,000 INF 200,000

-008
76.88

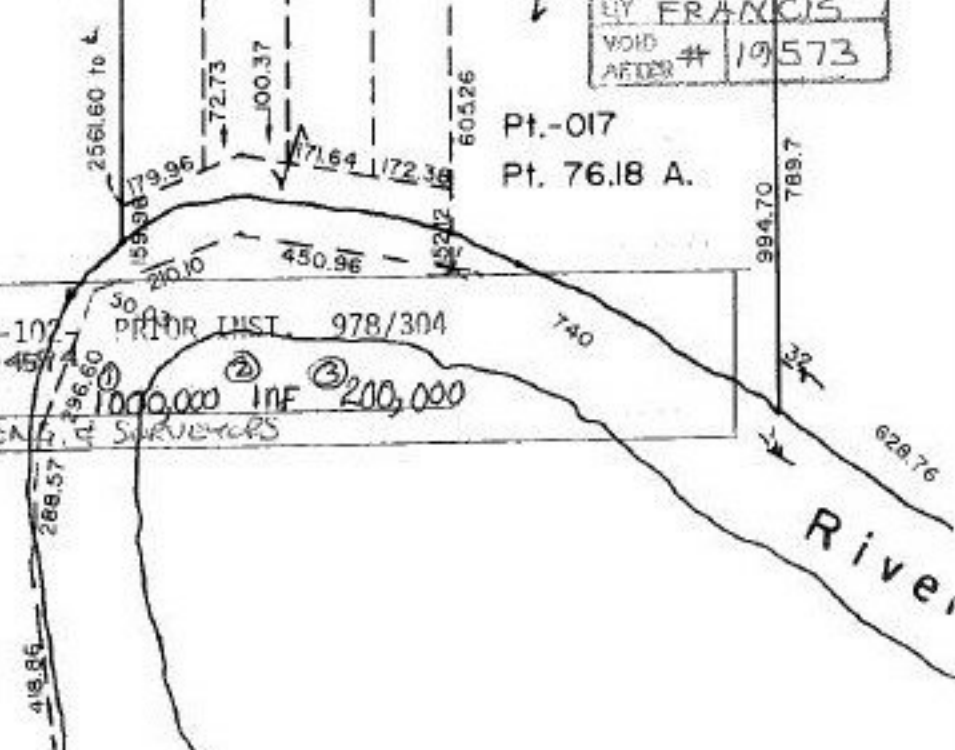

River