


SEE 10-00-007-H

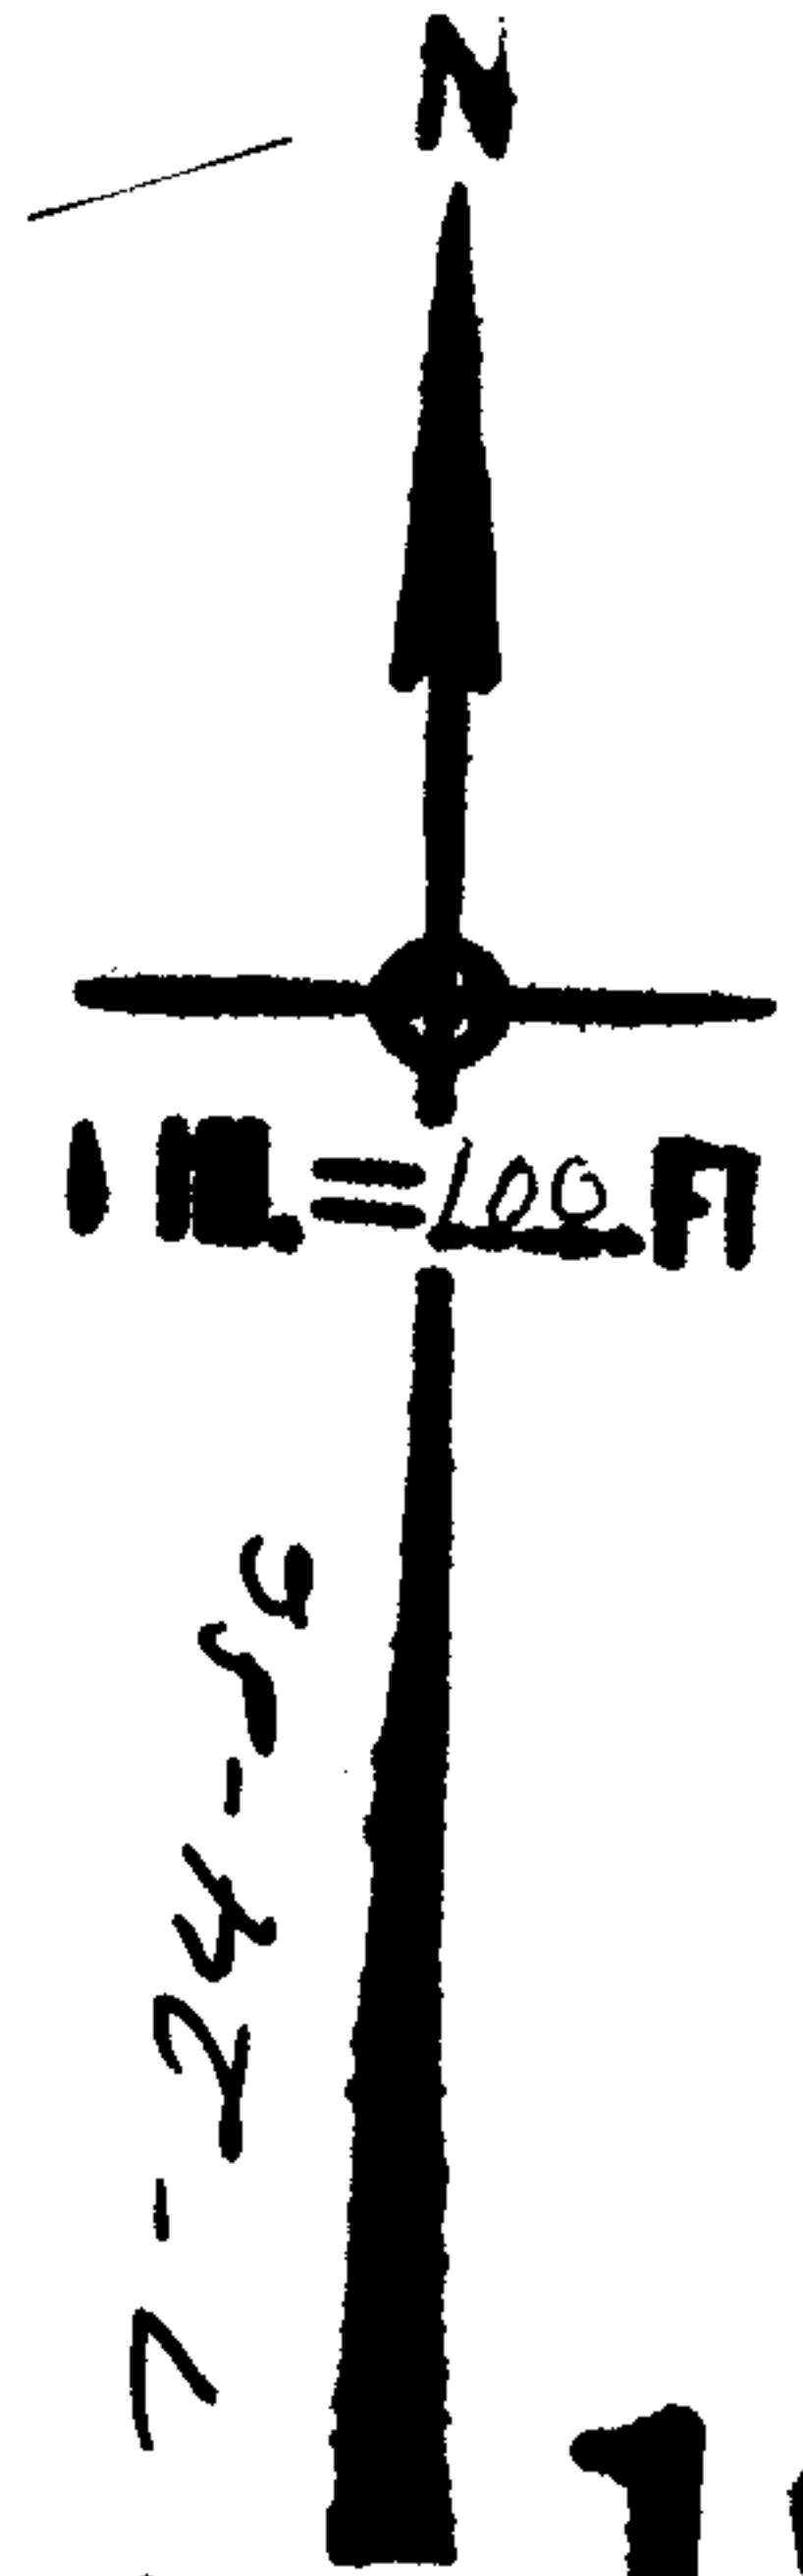

1958

D.S. 7-24-56

APPROVED
LORAIN CO.
MAP DEPT.
DATE 7-22-68
10-00-007-G
BY *Hollert*
9/30/68 R.K.



NO. 1

ORD.

S. 20° 11' 30" E.
175

87° 03' 30"
157.47

282.74
168.26
164.43

-032
1.28 A.

-049
1.48 A.

~~015~~
~~3.33 A.~~
1.01 A.

-048
0.84 A.

-036
0.41 A.

-031
0.71 A.

-030
1.01 A.

836.09

160.43

-035
0.52 A.

91.50

168.94

173.39

130.37

137.37

174.50

137.37

264.17

126.50

134.57

27.91

260.78

172.62

161.33

271.09

-028
0.86 A.

-027
1.02 A.

1.54 A.

39

180

271.98

127

93

113° 24'

66° 36'

161.63

154.93

-022
0.25 A.

267.74 STA. 755+73.76

688.75

688.75

