


1.0000

402.54

814.58
150.00
<u>964.58</u>

814.58	825.85
300.00	300.23
<u>514.58</u>	<u>525.62</u>

COOPER - FOSTER - PARK RD.

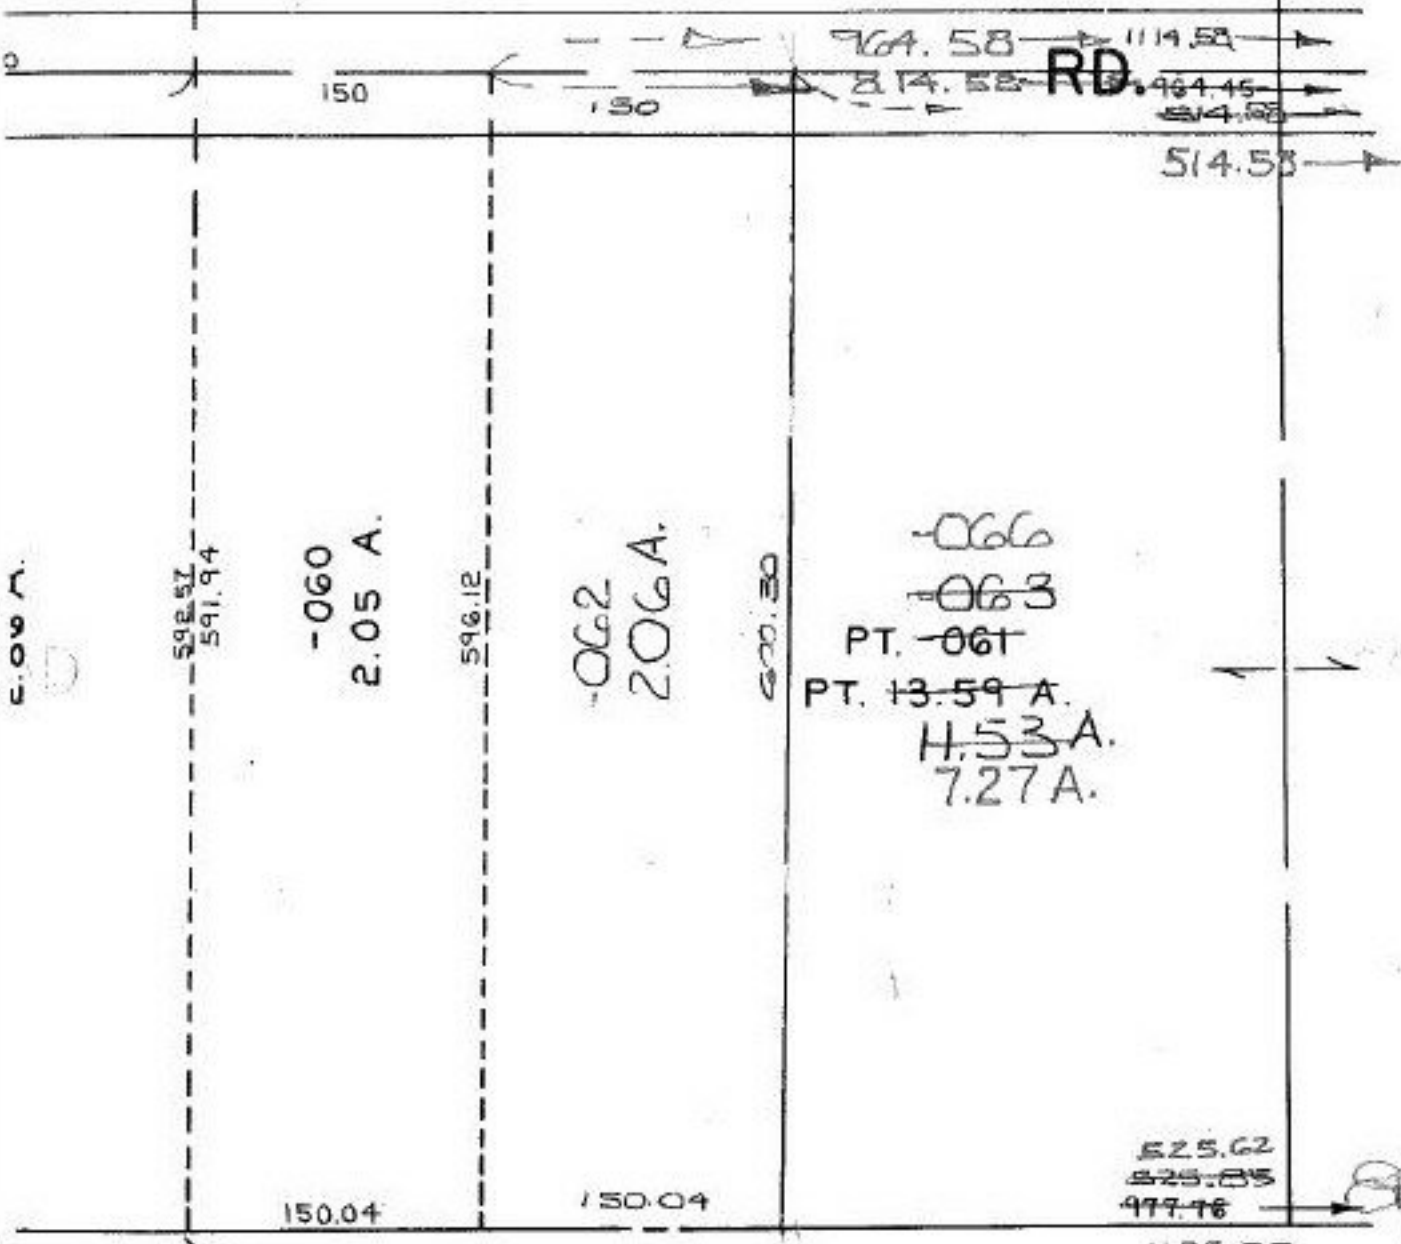

1.0000

592.57
591.94

-060
2.05 A.

596.12

-062
2.06 A.

500.30

-066
-063
PT. -061
PT. 13.59 A.
H.53 A.
7.27 A.

525.62
525.85
477.76

1125.73

12/26/91

19595

01 - 00 - 027 - 000 PRIOR INST. 933/860

APPROVED
LORAIN CO.
MAP DEPT.
DATE 10-3-91
PAGE 1-00-027-A
CAROLYN
BY FRANCIS
VOID AFTER
19595