


THIS 100A. PARCEL DESCRIBED w/
106/553 SEE #18091

RD.

3475

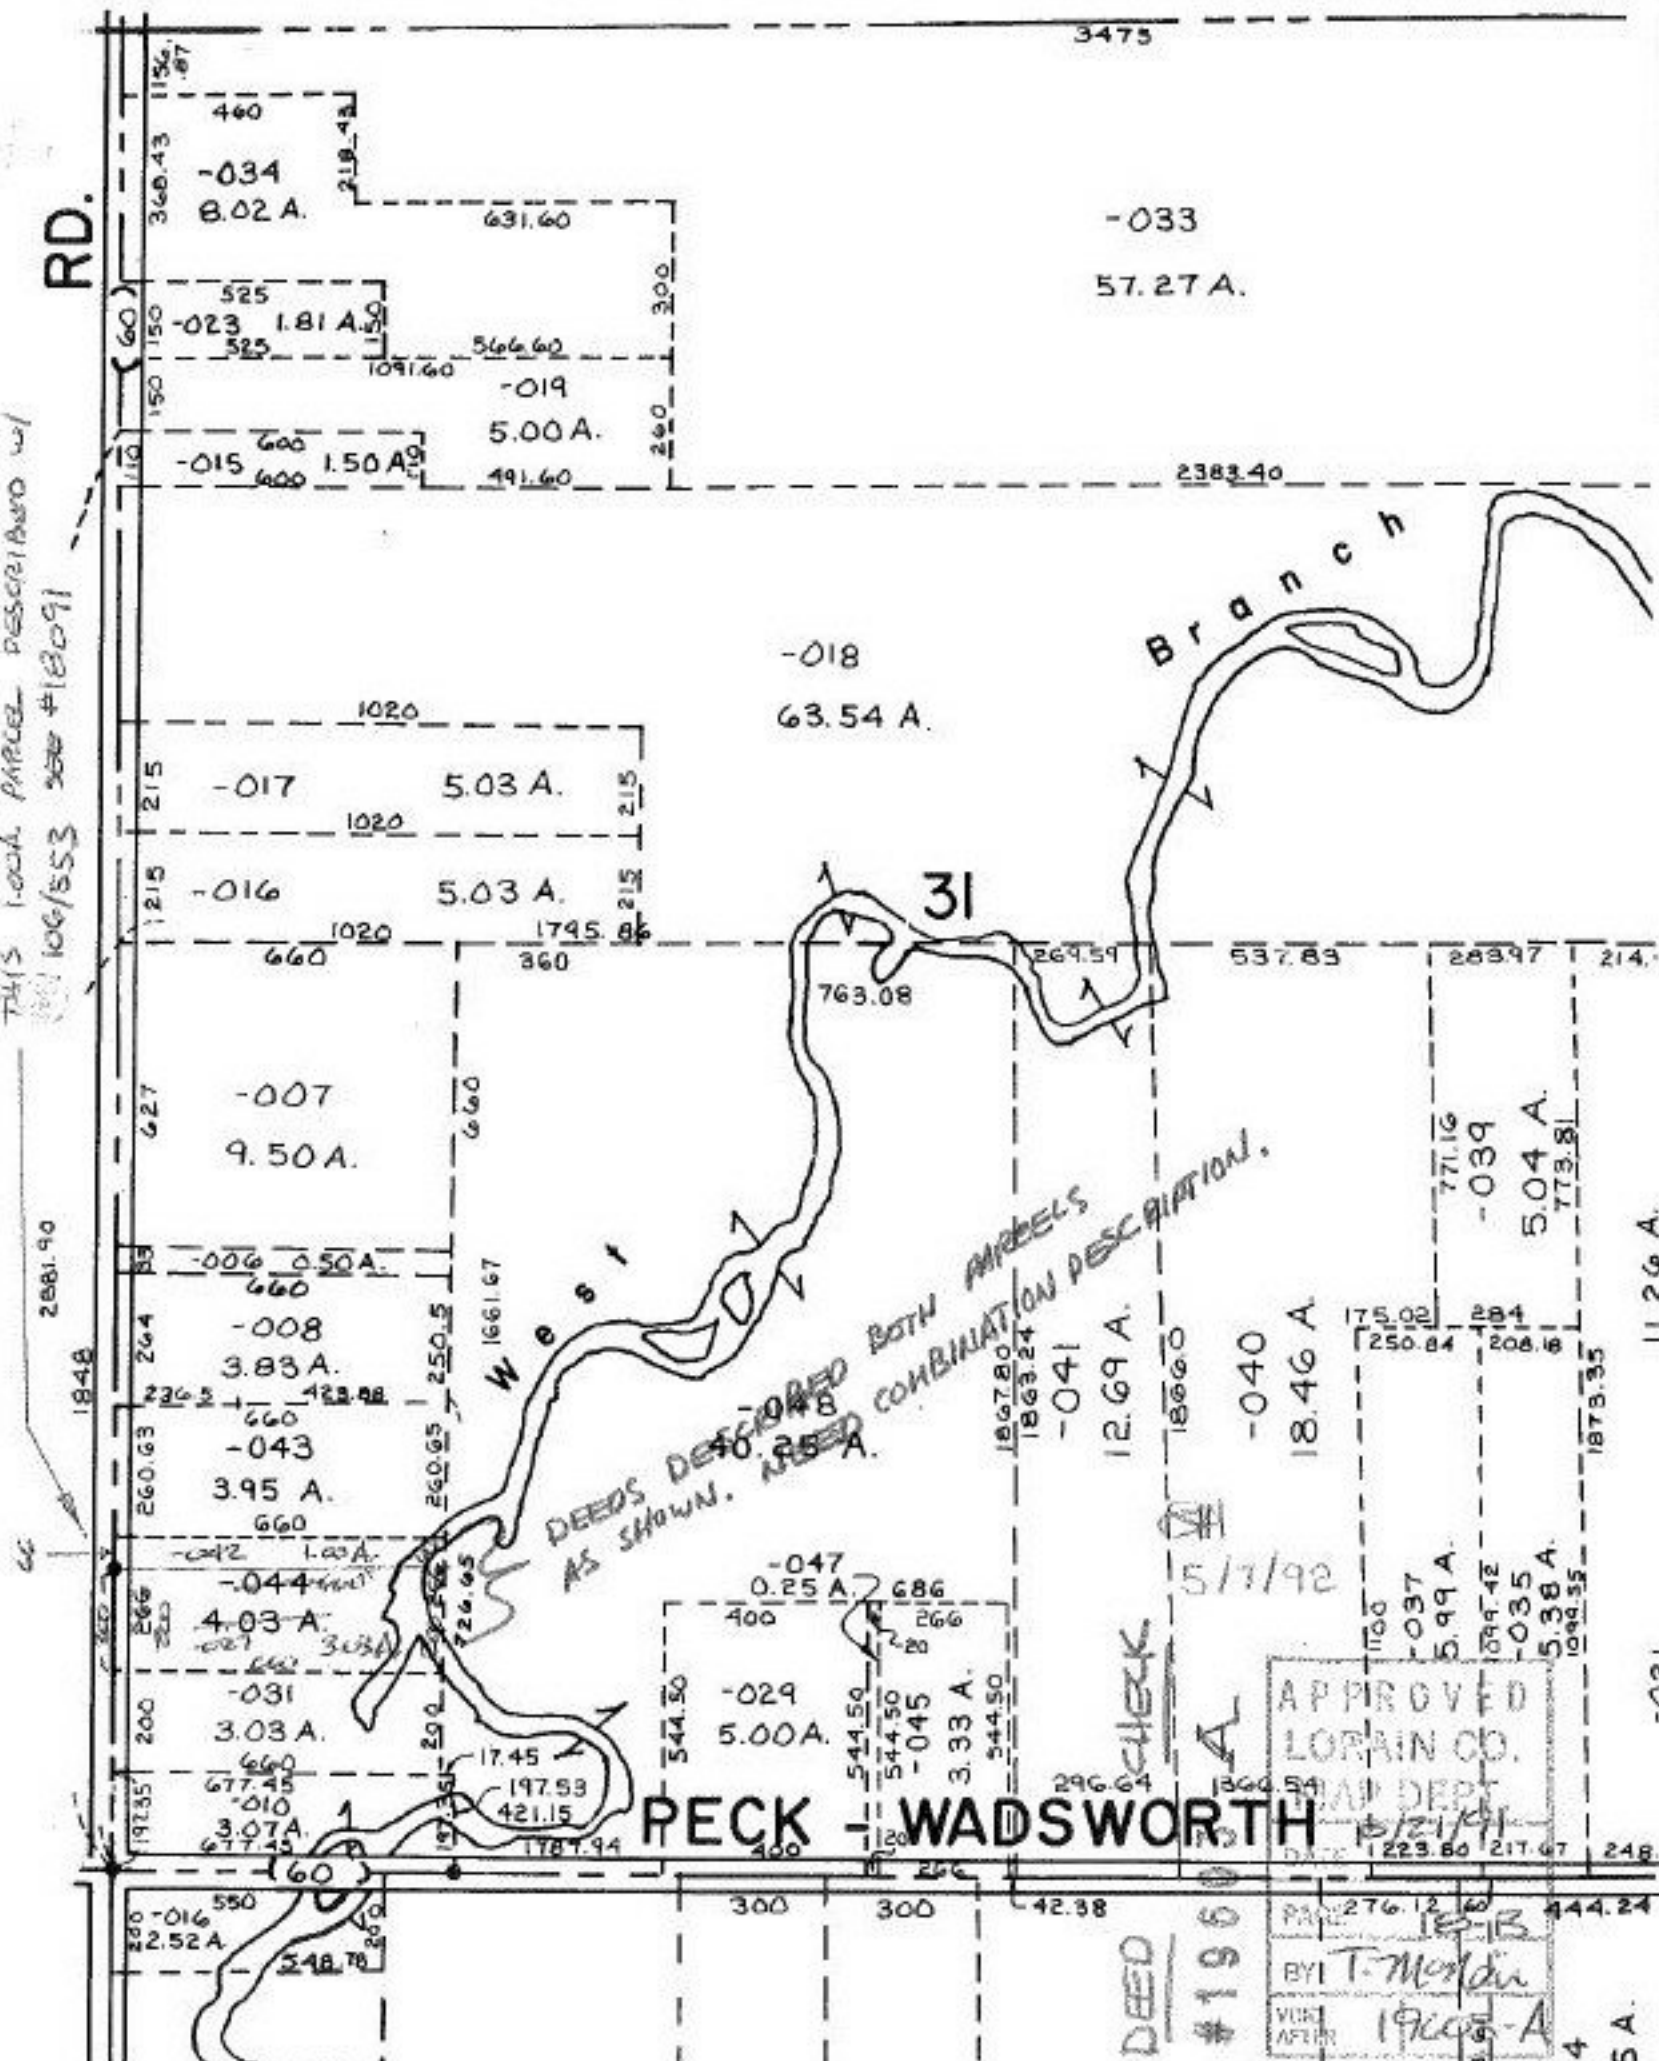

DEEDS DESCRIBED BOTH PARCELS
AS SHOWN. NEED COMBINATION DESCRIPTION.

PECK WADSWORTH

APPROVED
LORAIN CO.
CLERK DEPT.
DATE 1223.80 217.67 248.
BY T. Mordan
1920-5-A

DEED #1960

PAGE 276.12 444.24

14 5A