


SEE 4-00-002-

NORTH RIDGE

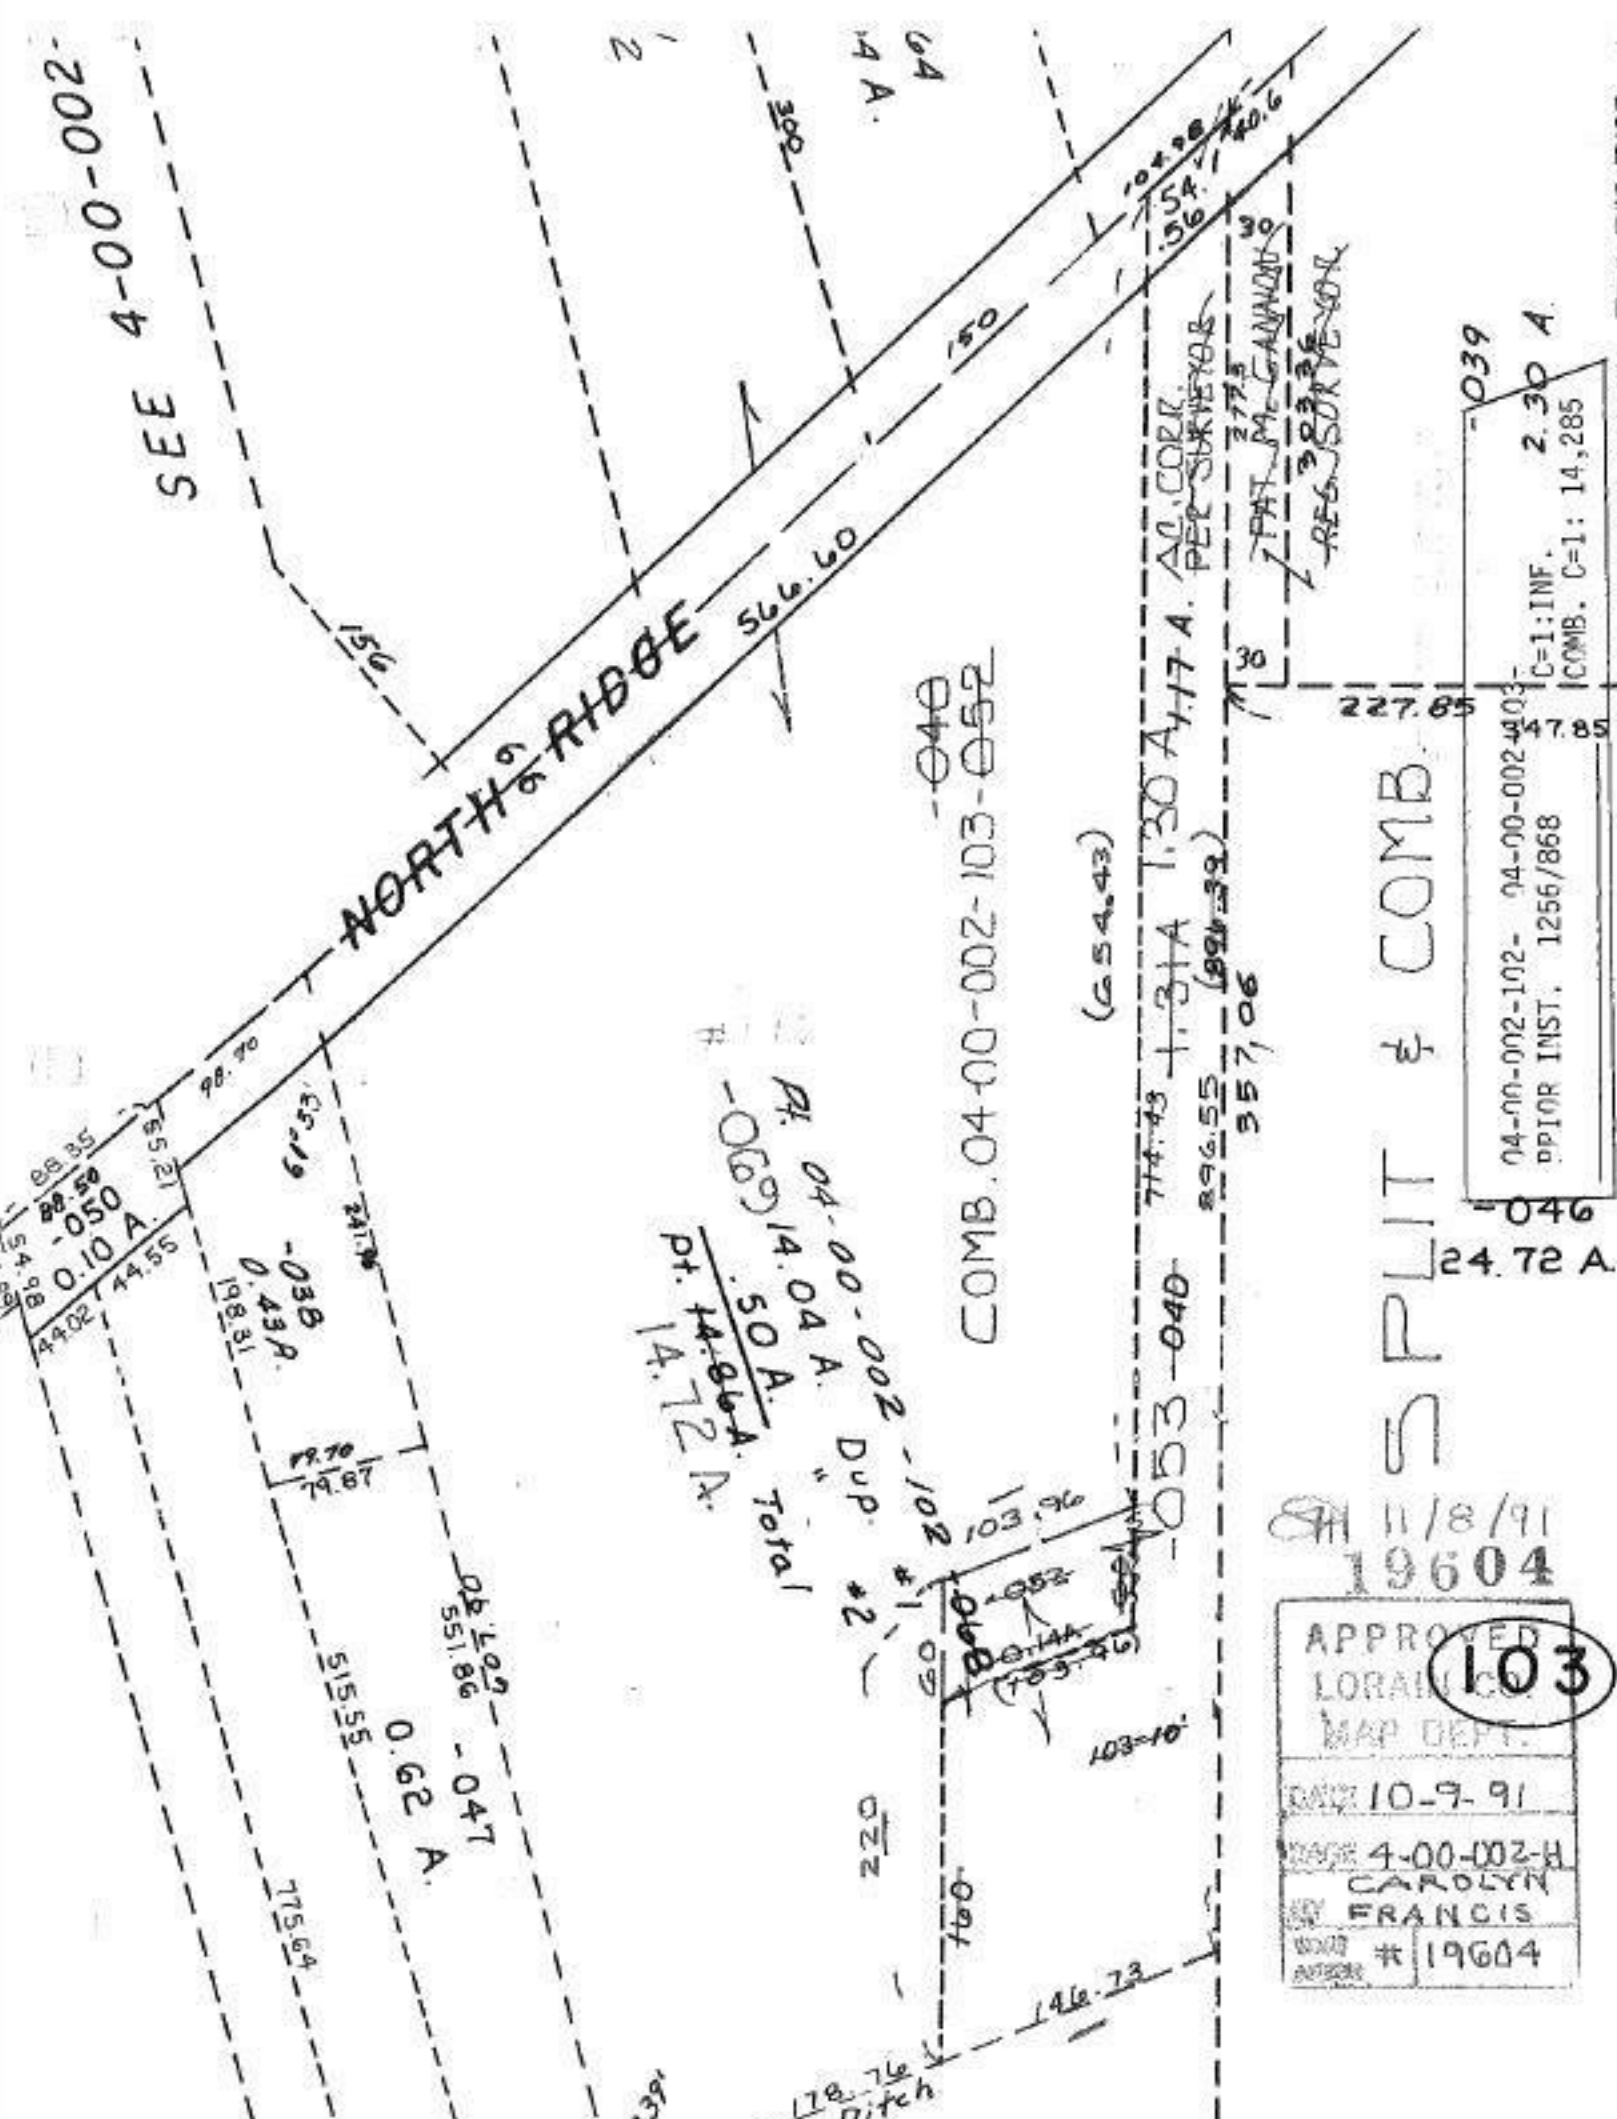

COMB. 04-00-002-103-052  
 (654.43)  
 774.43 1.31A 1.30 A-17 A. AC. CORR. PER SURVEYOR  
 896.55 (894.39)  
 357.06

Pt. 04-00-002 Dup #2  
 Pt. 14-06-A  
 Pt. 14-72-A  
 .50 A. Total

11/8/91  
 19604

APPROVED  
 LORANCO  
 MAP DEPT.  
 DATE 10-9-91  
 PAGE 4-00-002-H  
 BY CAROLYN  
 # 19604

103

046  
 24.72 A  
 039  
 C-1: INF. 2.30 A  
 COMB. C-1: 14,285

MAP DRAWN FROM RECORD BY PAT MCGANNON REG. SURVEYOR