


047-000-
33.85 A.
Pt. 07-00-047-
Pt. 20.14 A.
SUGAR RIDGE
Pt. 07-00-047-000-015
Pt. 1.00 A.

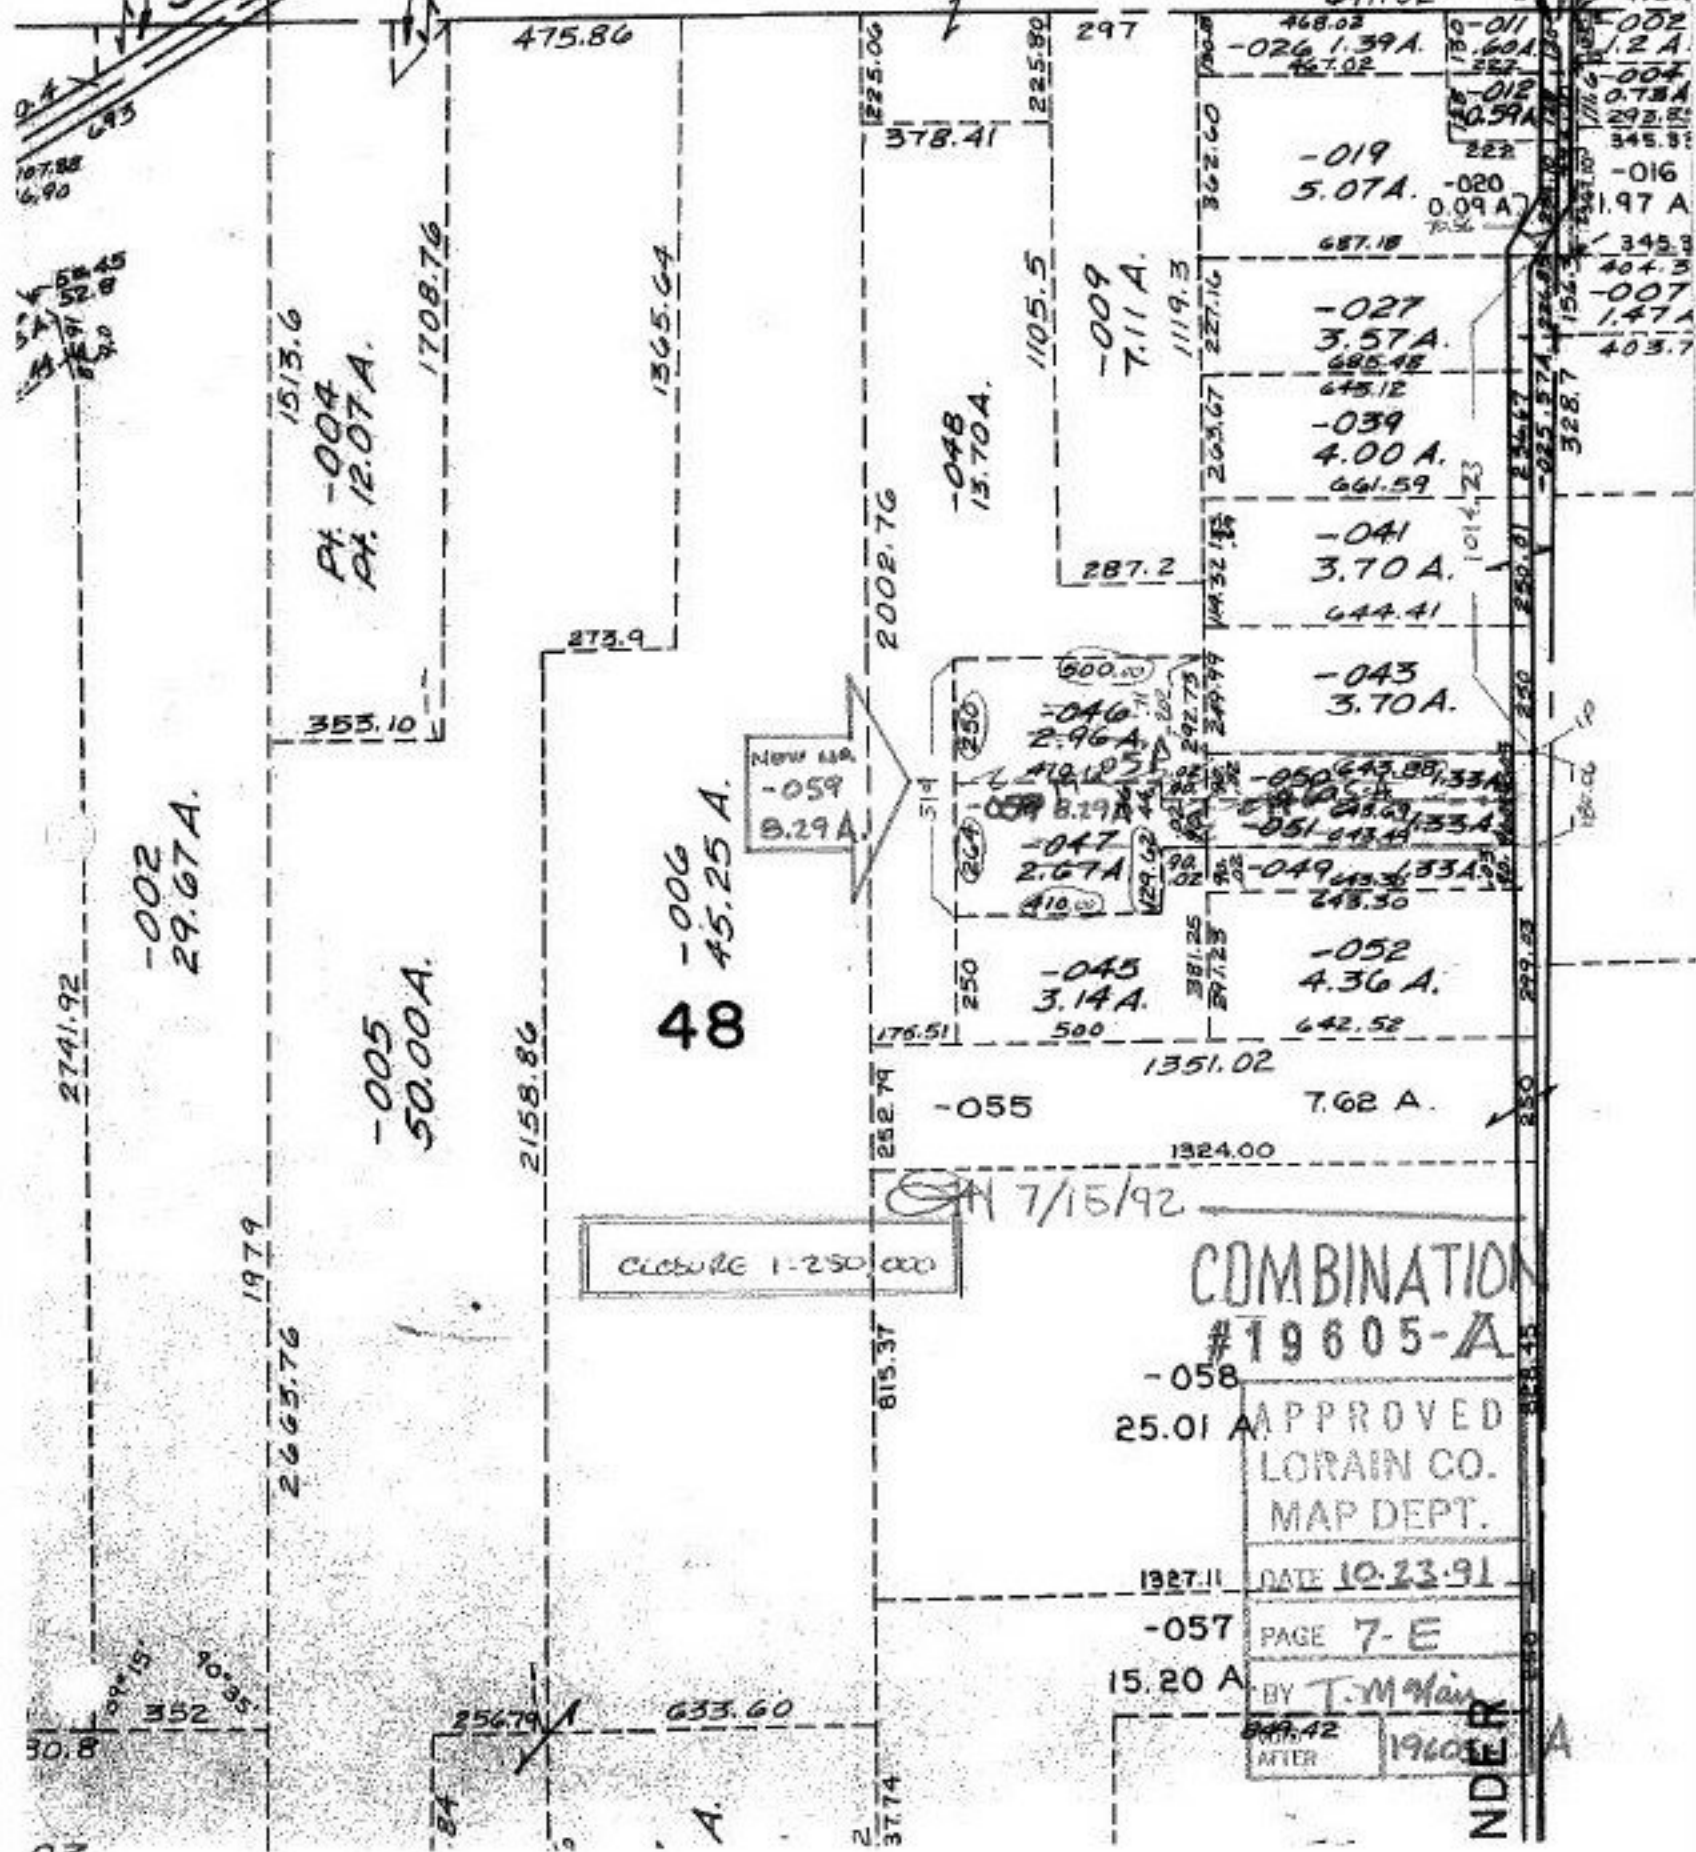

CLOSURE 1-250,000

COMBINATION
#19605-A

-058
25.01 A. APPROVED
LORAIN CO.
MAP DEPT.

1327.11 DATE 10-23-91

-057 PAGE 7-E

15.20 A. BY T.M. Han

847.42 AFTER 1960

INDEX