


0.97A
0.24A
0.73A

SEE 3-00-006-A

ABBE RD.

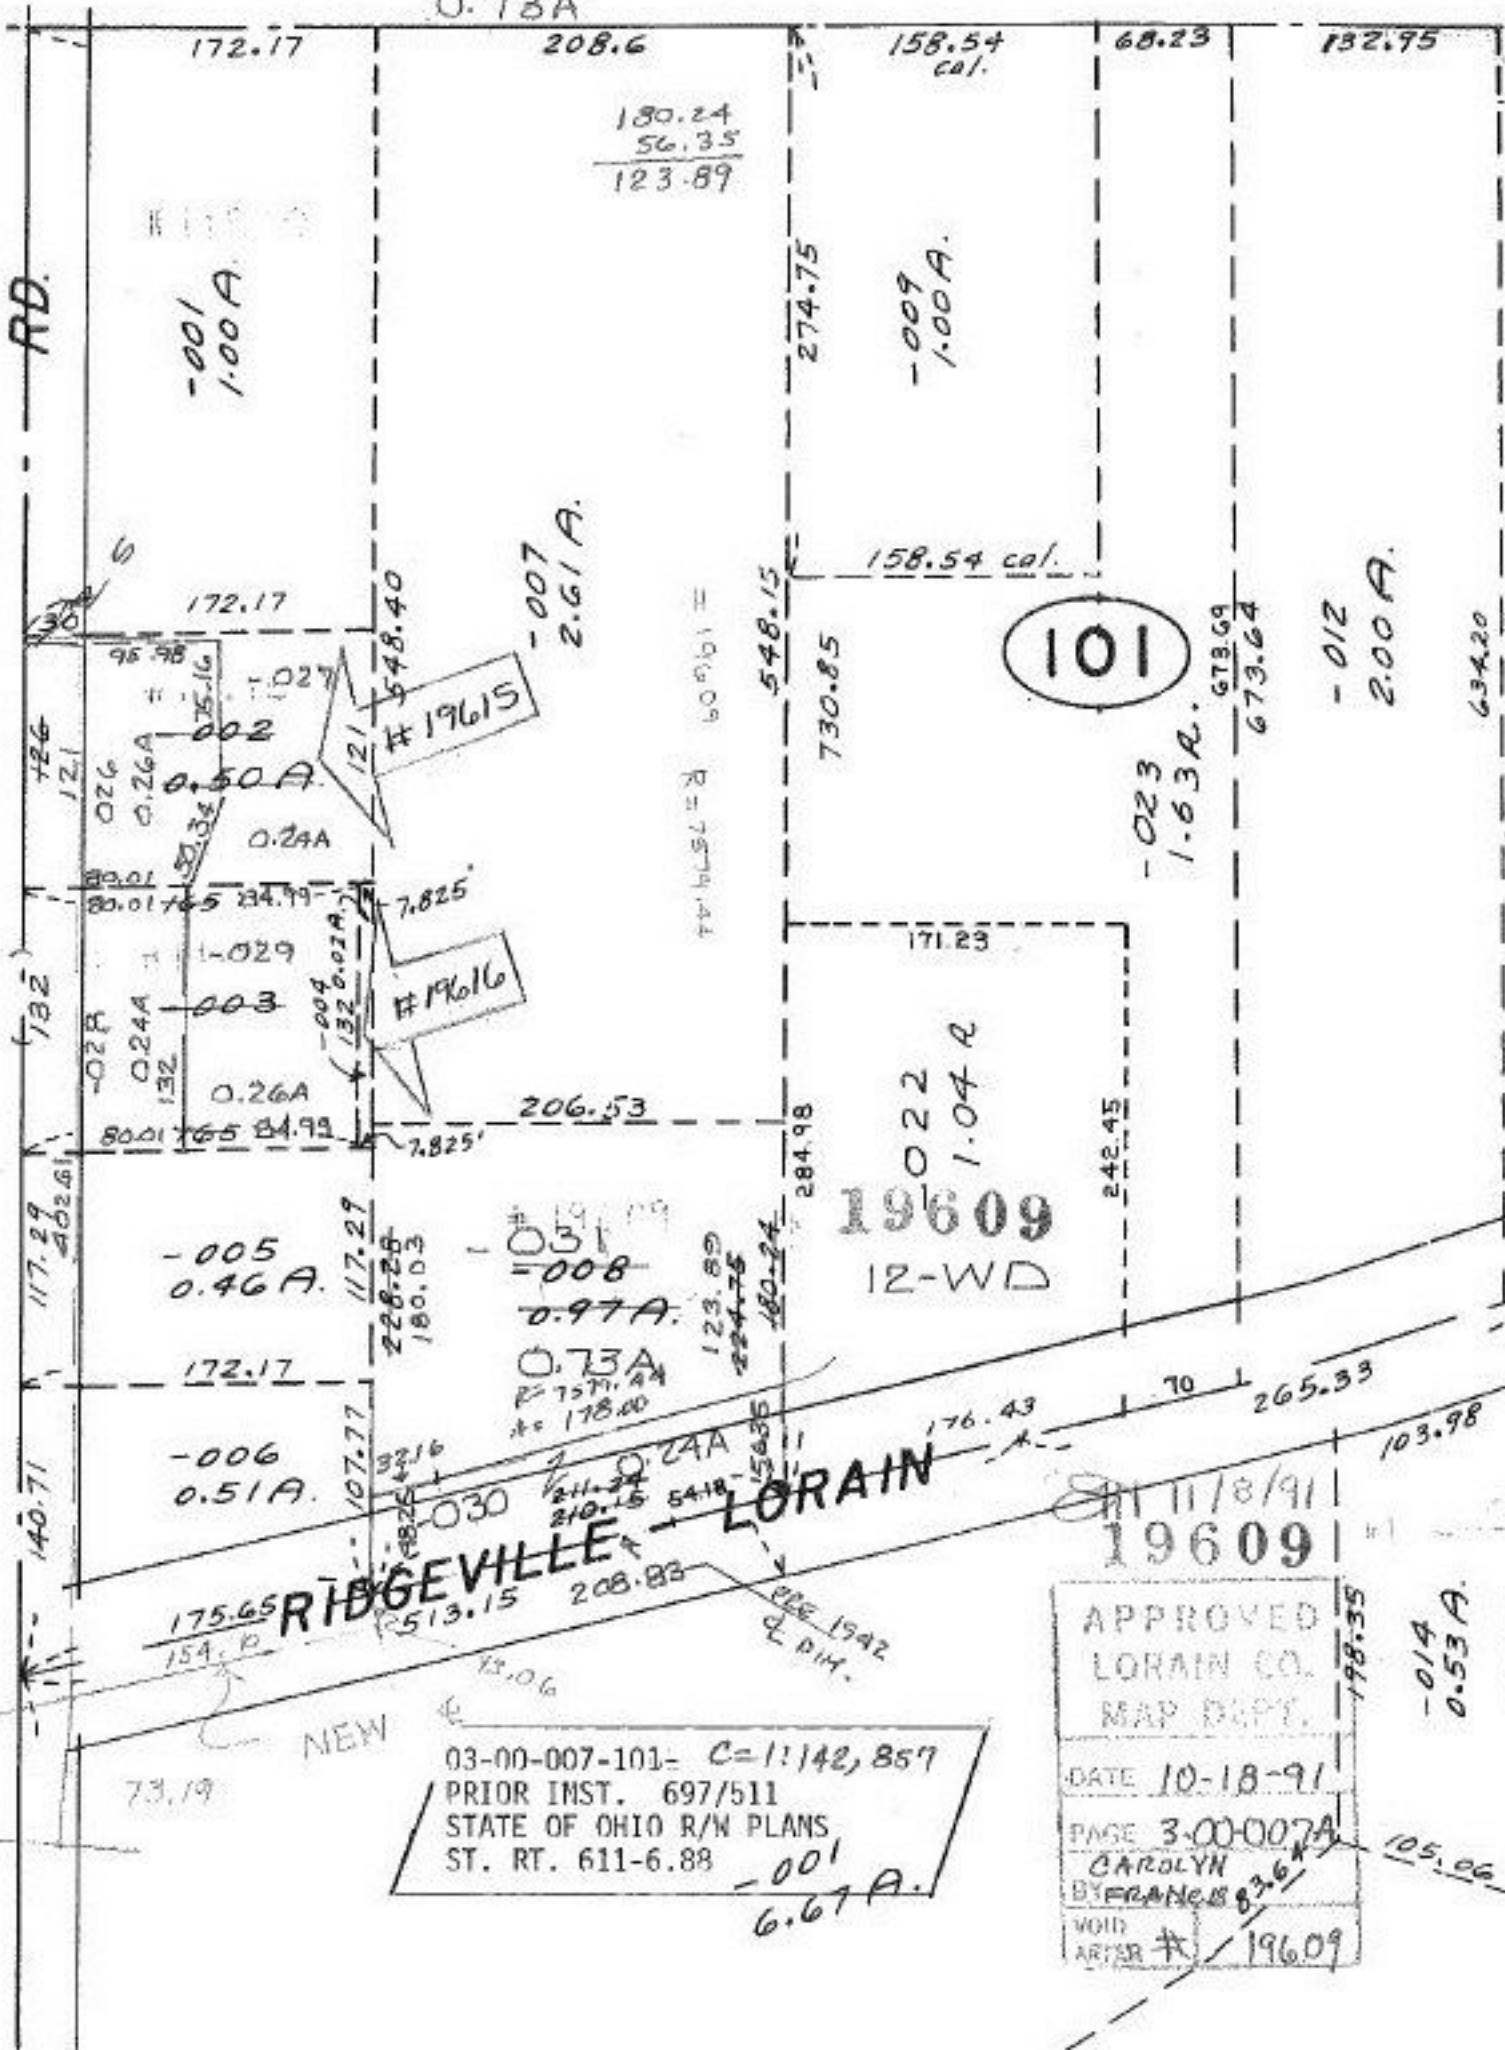

RD.

132

117.29

140.71

175.65

73.19

NEW

-001
1.00A

-002
0.50A

-003
0.24A

-005
0.46A

-006
0.51A

-007
2.61A

-008
0.97A

0.24A

-009
1.00A

19609
12-WD

-001
6.67A

101

-023
1.63A

-014
0.53A

-012
2.00A

APPROVED
LORAIN CO.
MAP DEPT.
DATE 10-18-91
PAGE 3-00-007A
CAROLYN
BYRANE 876/19609
VOID
AFTER # 19609

03-00-007-101- C=1:142,857
PRIOR INST. 697/511
STATE OF OHIO R/W PLANS
ST. RT. 611-6.88

180.24
56.35
123.89

19609
12-WD

11/8/91
19609

105.06

103.98

242.45

284.98

274.75

158.54 cal.

68.23

132.95

634.20

673.64

673.69

171.23

206.53

208.83

251.15

208.83

176.43

170.24

180.24

123.89

121

117.29

172.17

172.17

208.6

158.54 cal.

158.54 cal.

