

03-00-017-101- PRIOR INST. #19610 3/150
 #19611 118/102 #19612 69/99 #19613 145/57
 STATE OF OHIO R/W PLANS ST. RT. 611-6.88


RD.

12-VVD-1

-016
 11.28A.

101

19611
 19610

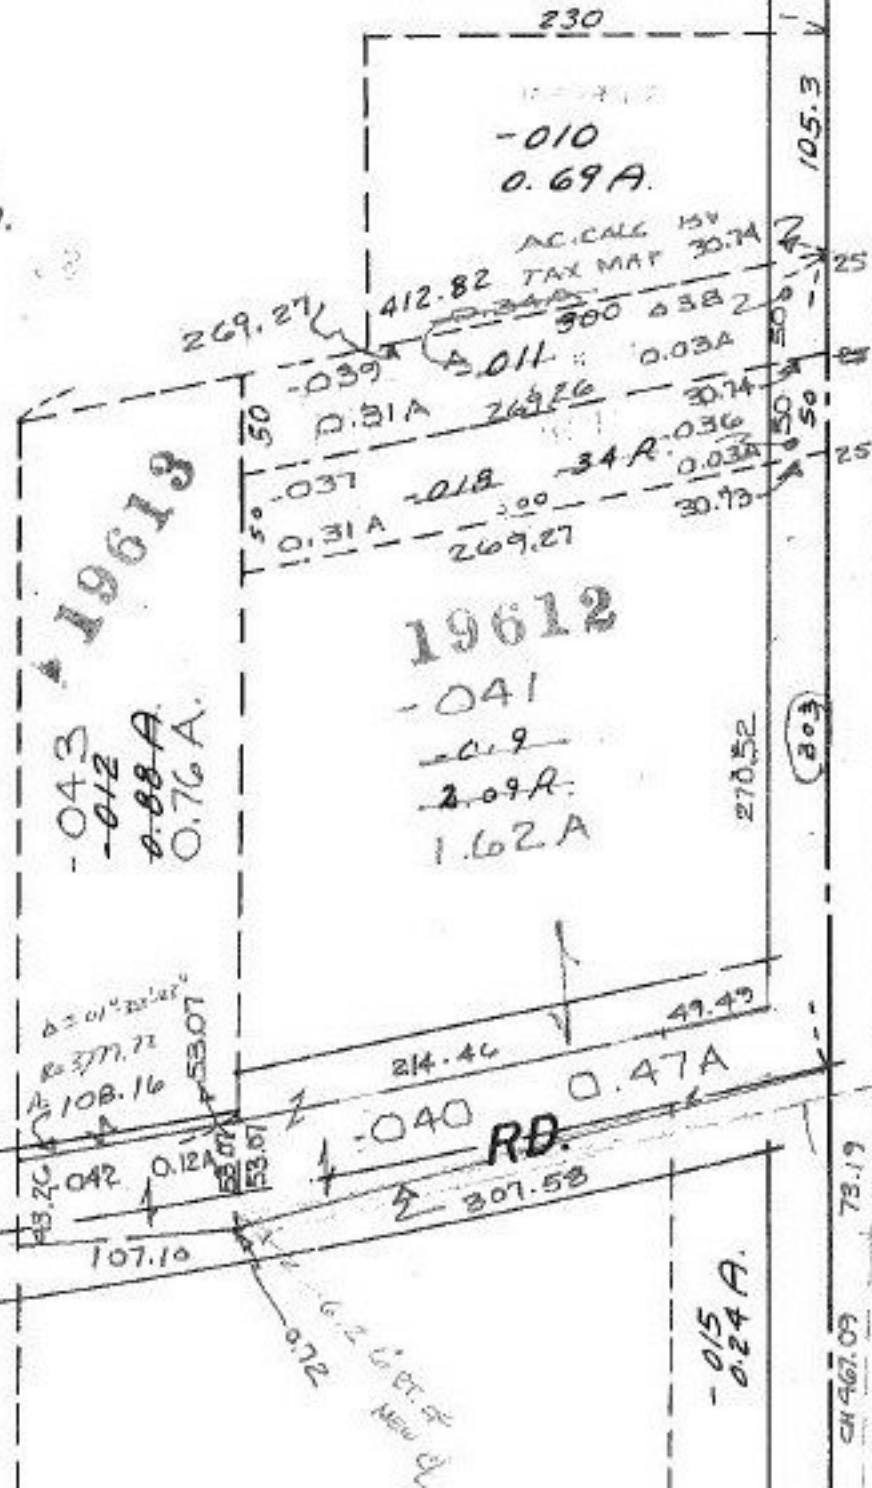

11/8/91
 19613
 19612
 19611
 19610

APPROVED
 CORN CO.
 STAP DEPT.
 DATE 10-18-91
 BY 3-00-017-B
 CAROLYN
 FRANCIS
 VON
 ARDEN # 19610
 19611, 12, 13