


RD. 60  
 24-001 148.27  
 23-002 151.76  
 293-003 118  
 292-004  
 291  
 290-005  
 289-006  
 288-007  
 287-008  
 286-009  
 285-010  
 284-011  
 283-012  
 282  
 281-013  
 280-014  
 279-015  
 278-016  
 277-017  
 276-018  
 275-019  
 274-020  
 273-021

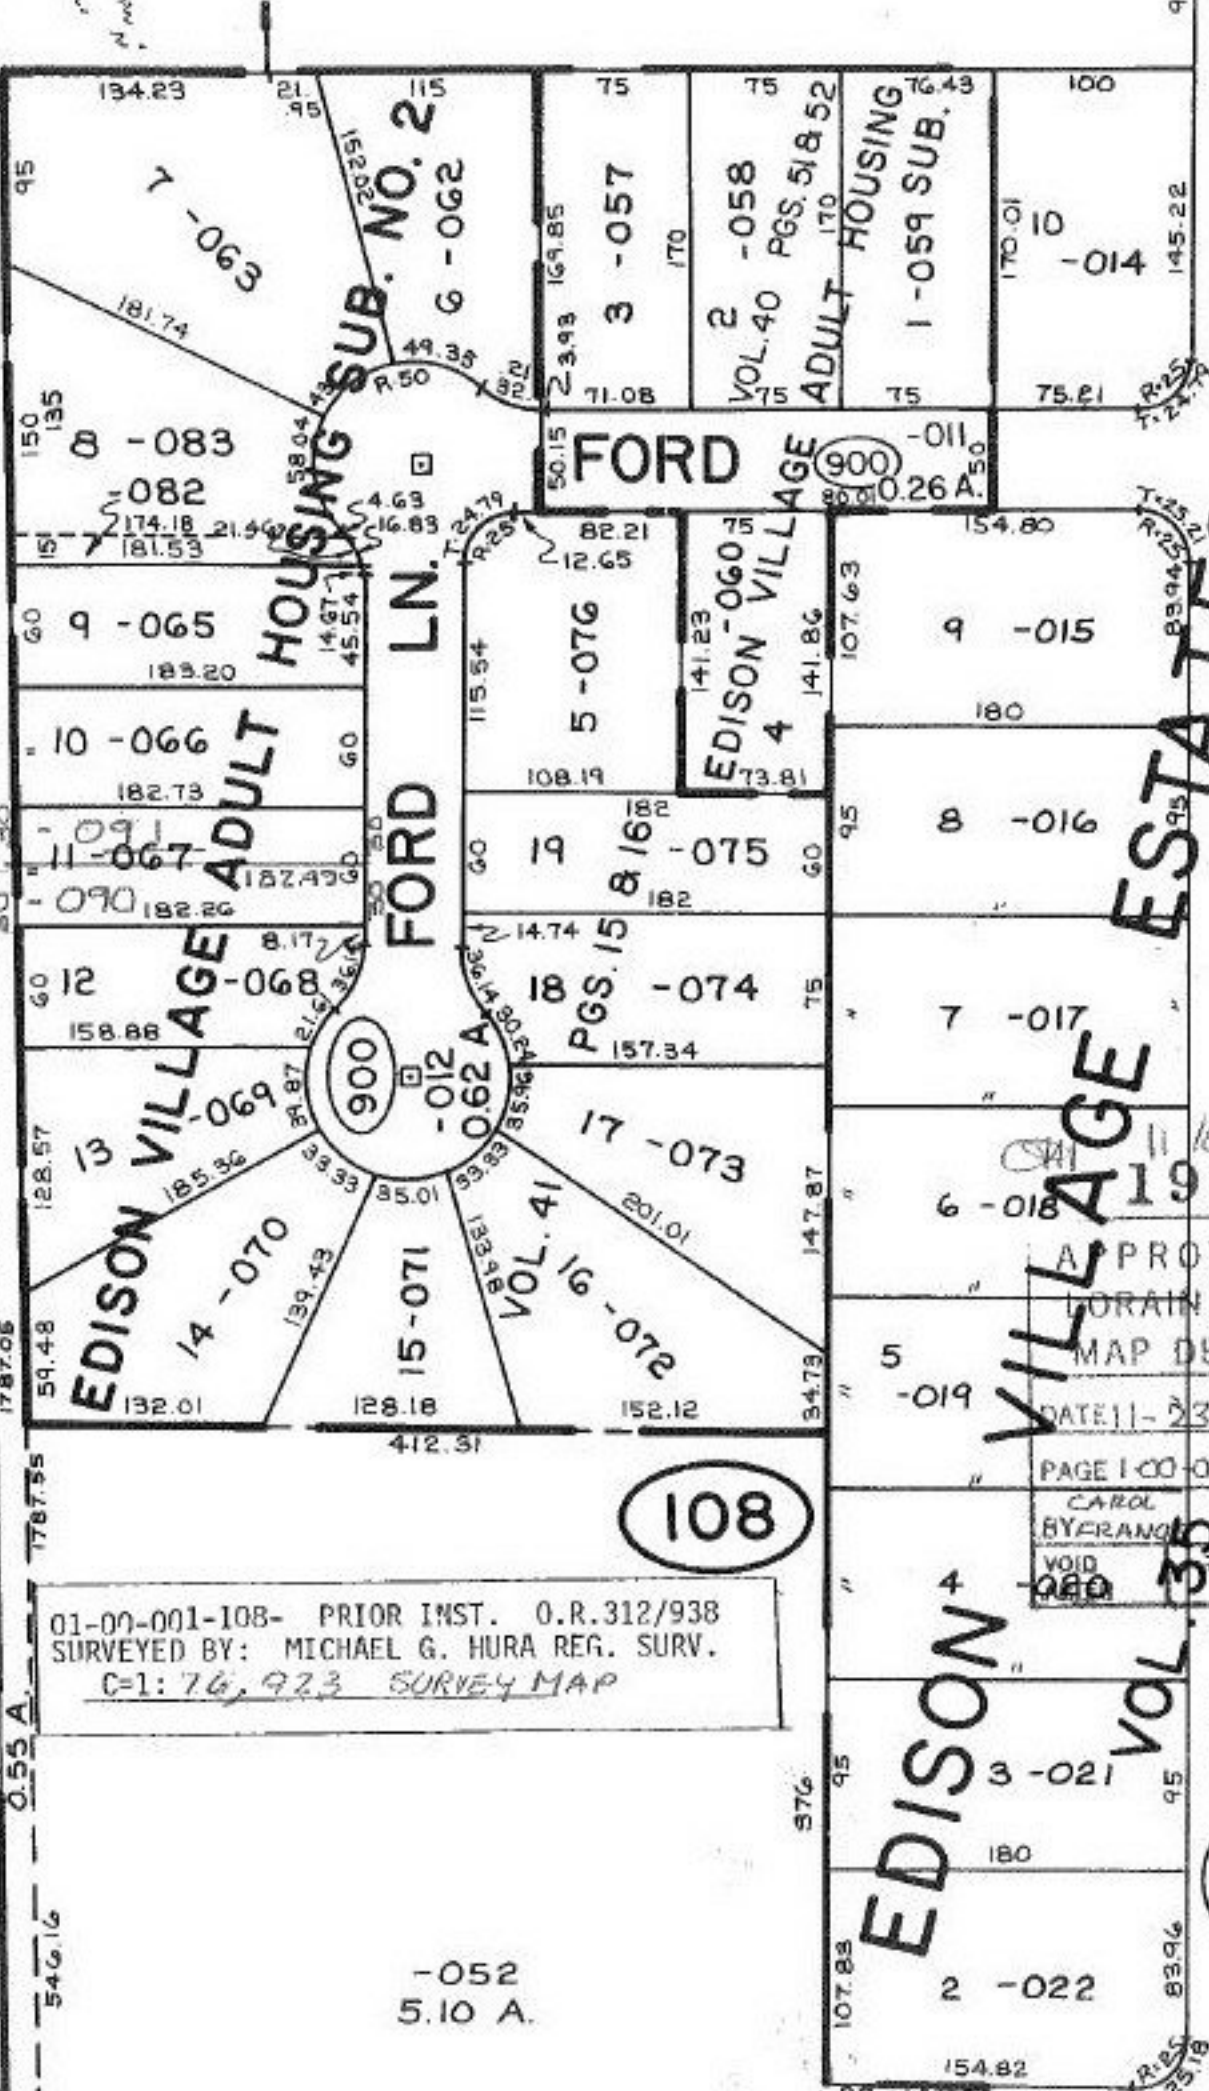

DR. SUB. 15  
 16  
 17  
 18  
 19  
 20  
 21  
 22  
 23  
 24

**PGS. 72 a - 1**

**APPROVED 1961**  
 LORAIN CO. MAP DEPT.  
 DATE 11-23-91  
 PAGE 1 CO-001-B  
 CAROL BYERANG  
 VOID 289  
 1961