


SEE 6-53

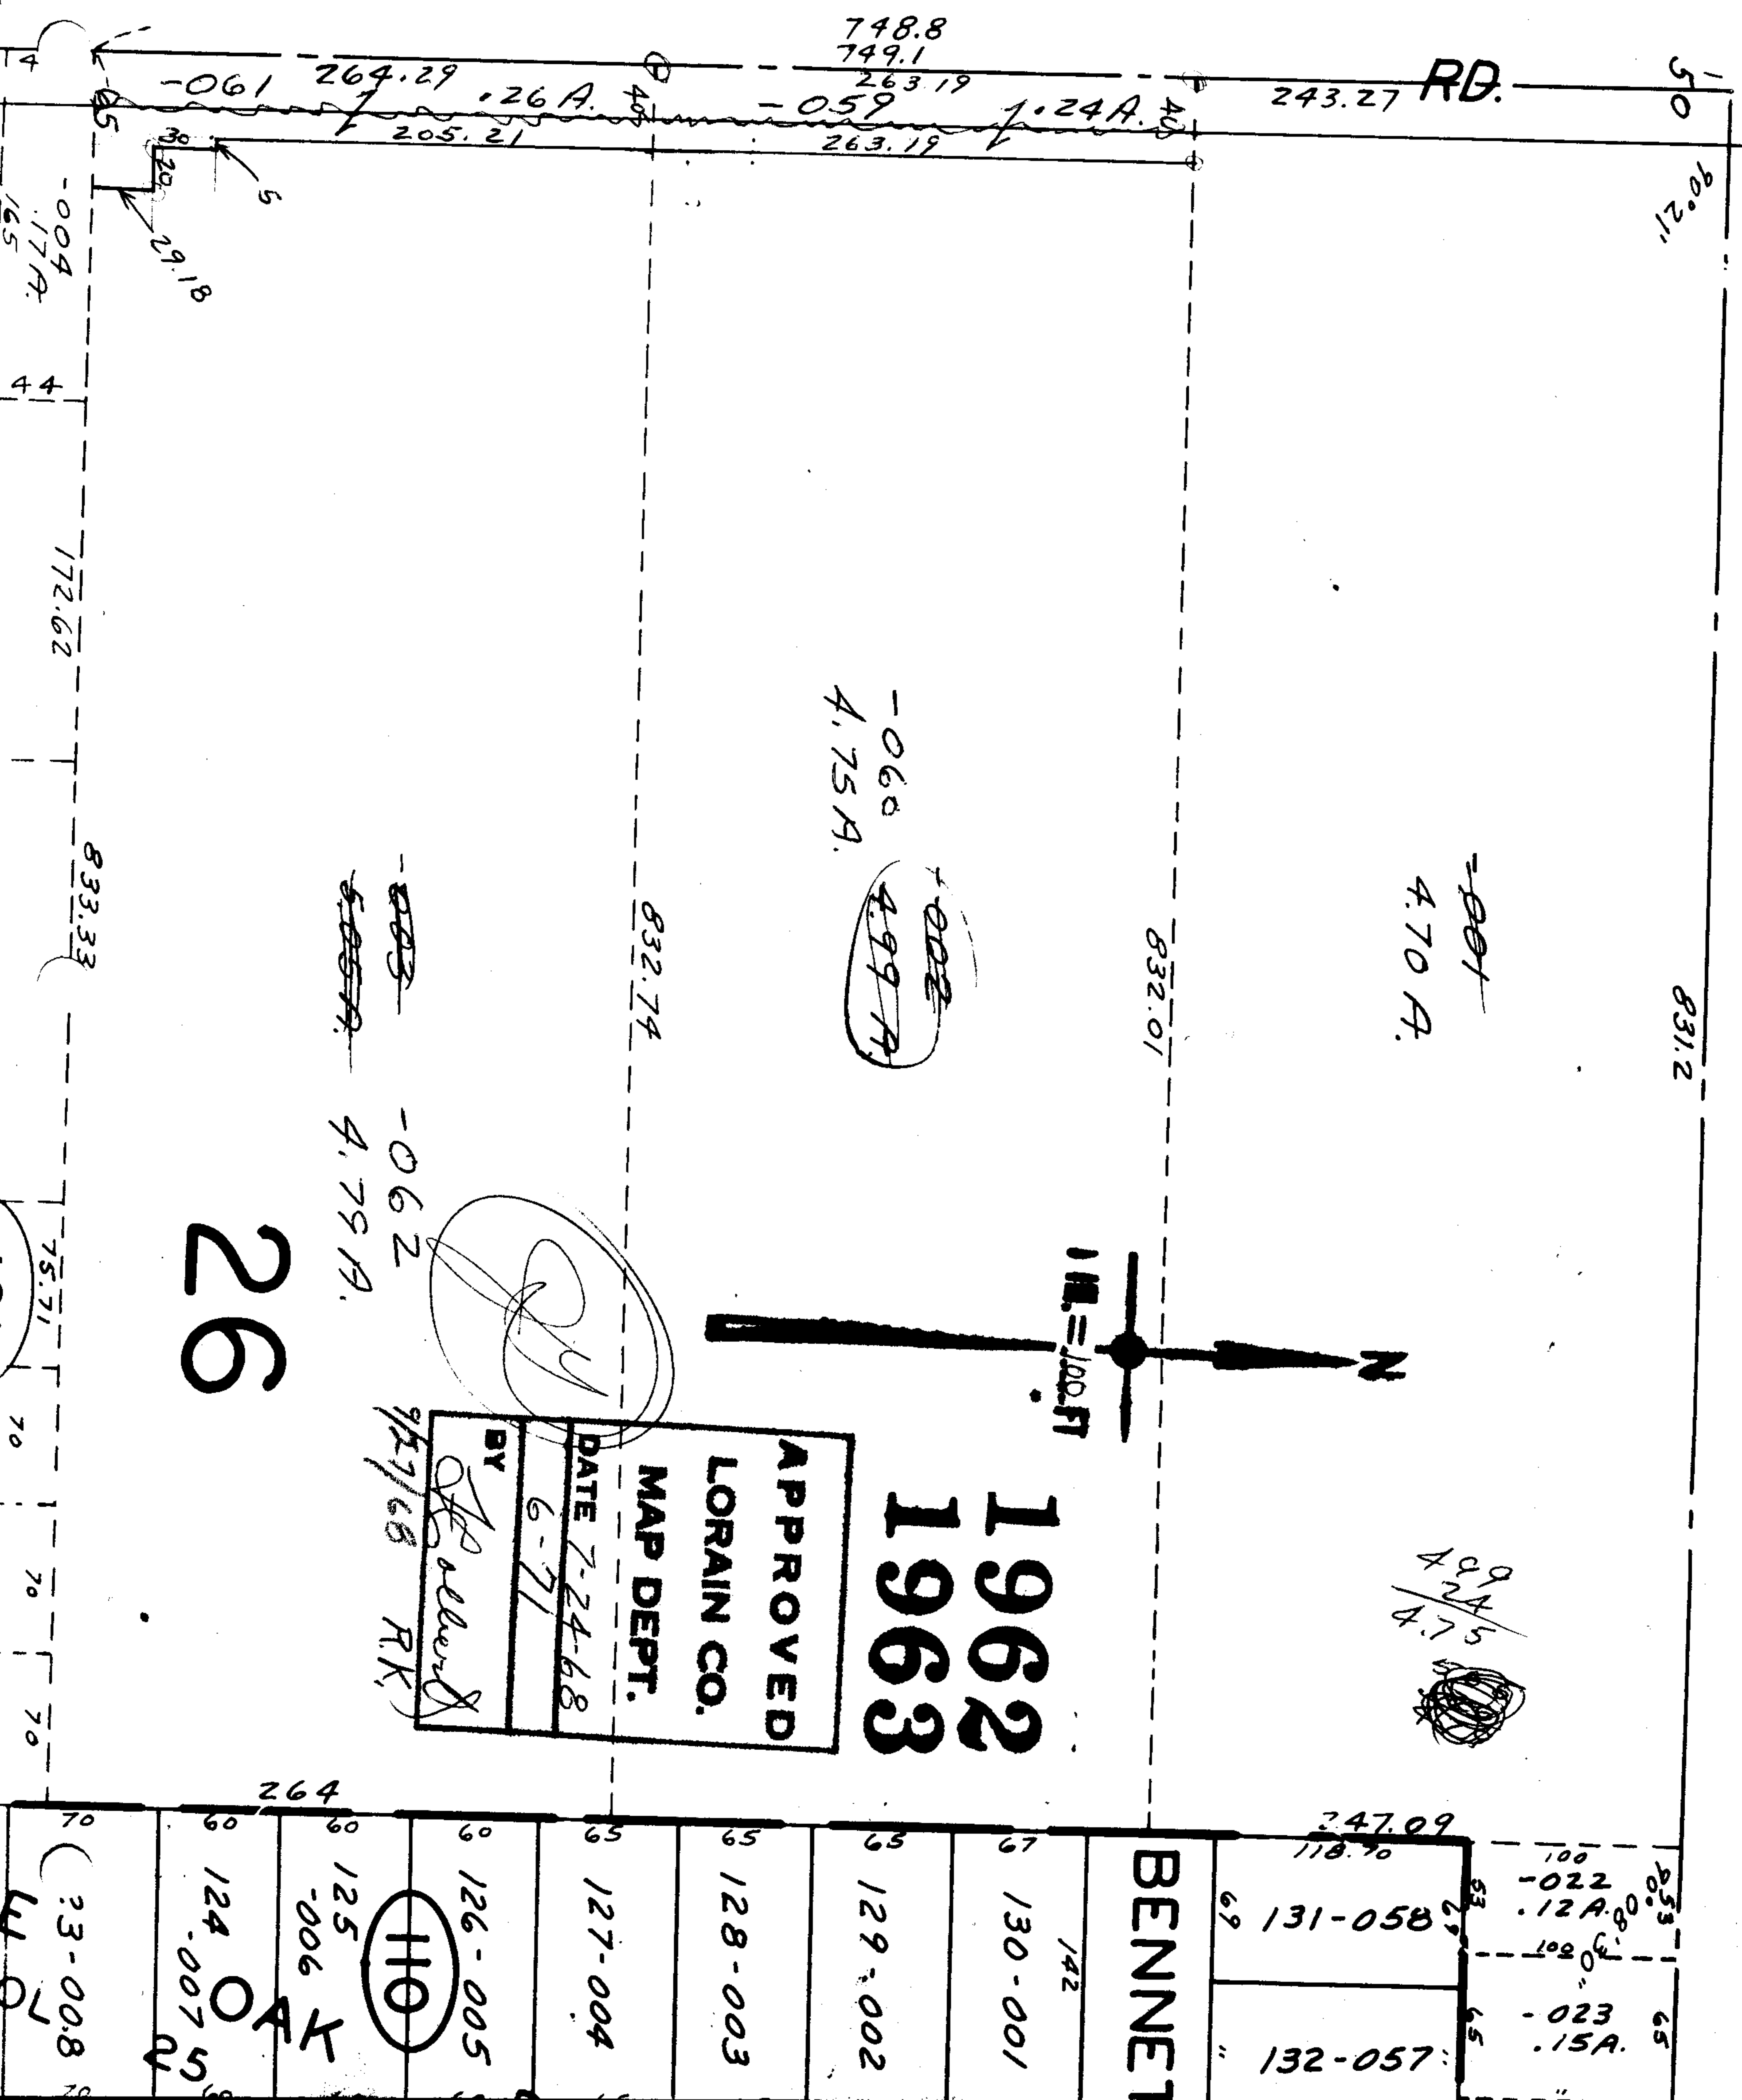

4.99  
2.24  
4.75

**1962**  
**1963**

**APPROVED**  
**LORAIN CO.**  
**MAP DEPT.**

DATE 7-24-68  
6-71

BY *[Signature]*  
9/27/68 RK

**26**

69	131-058	4.99 A.
65	132-057	4.70 A.
67	130-001	1.42
65	129-002	4.75 A.
65	128-003	
69	127-004	
69	126-005	110
69	125-006	K
69	124-007	A
70	123-008	W