


DETAIL

ST. 1

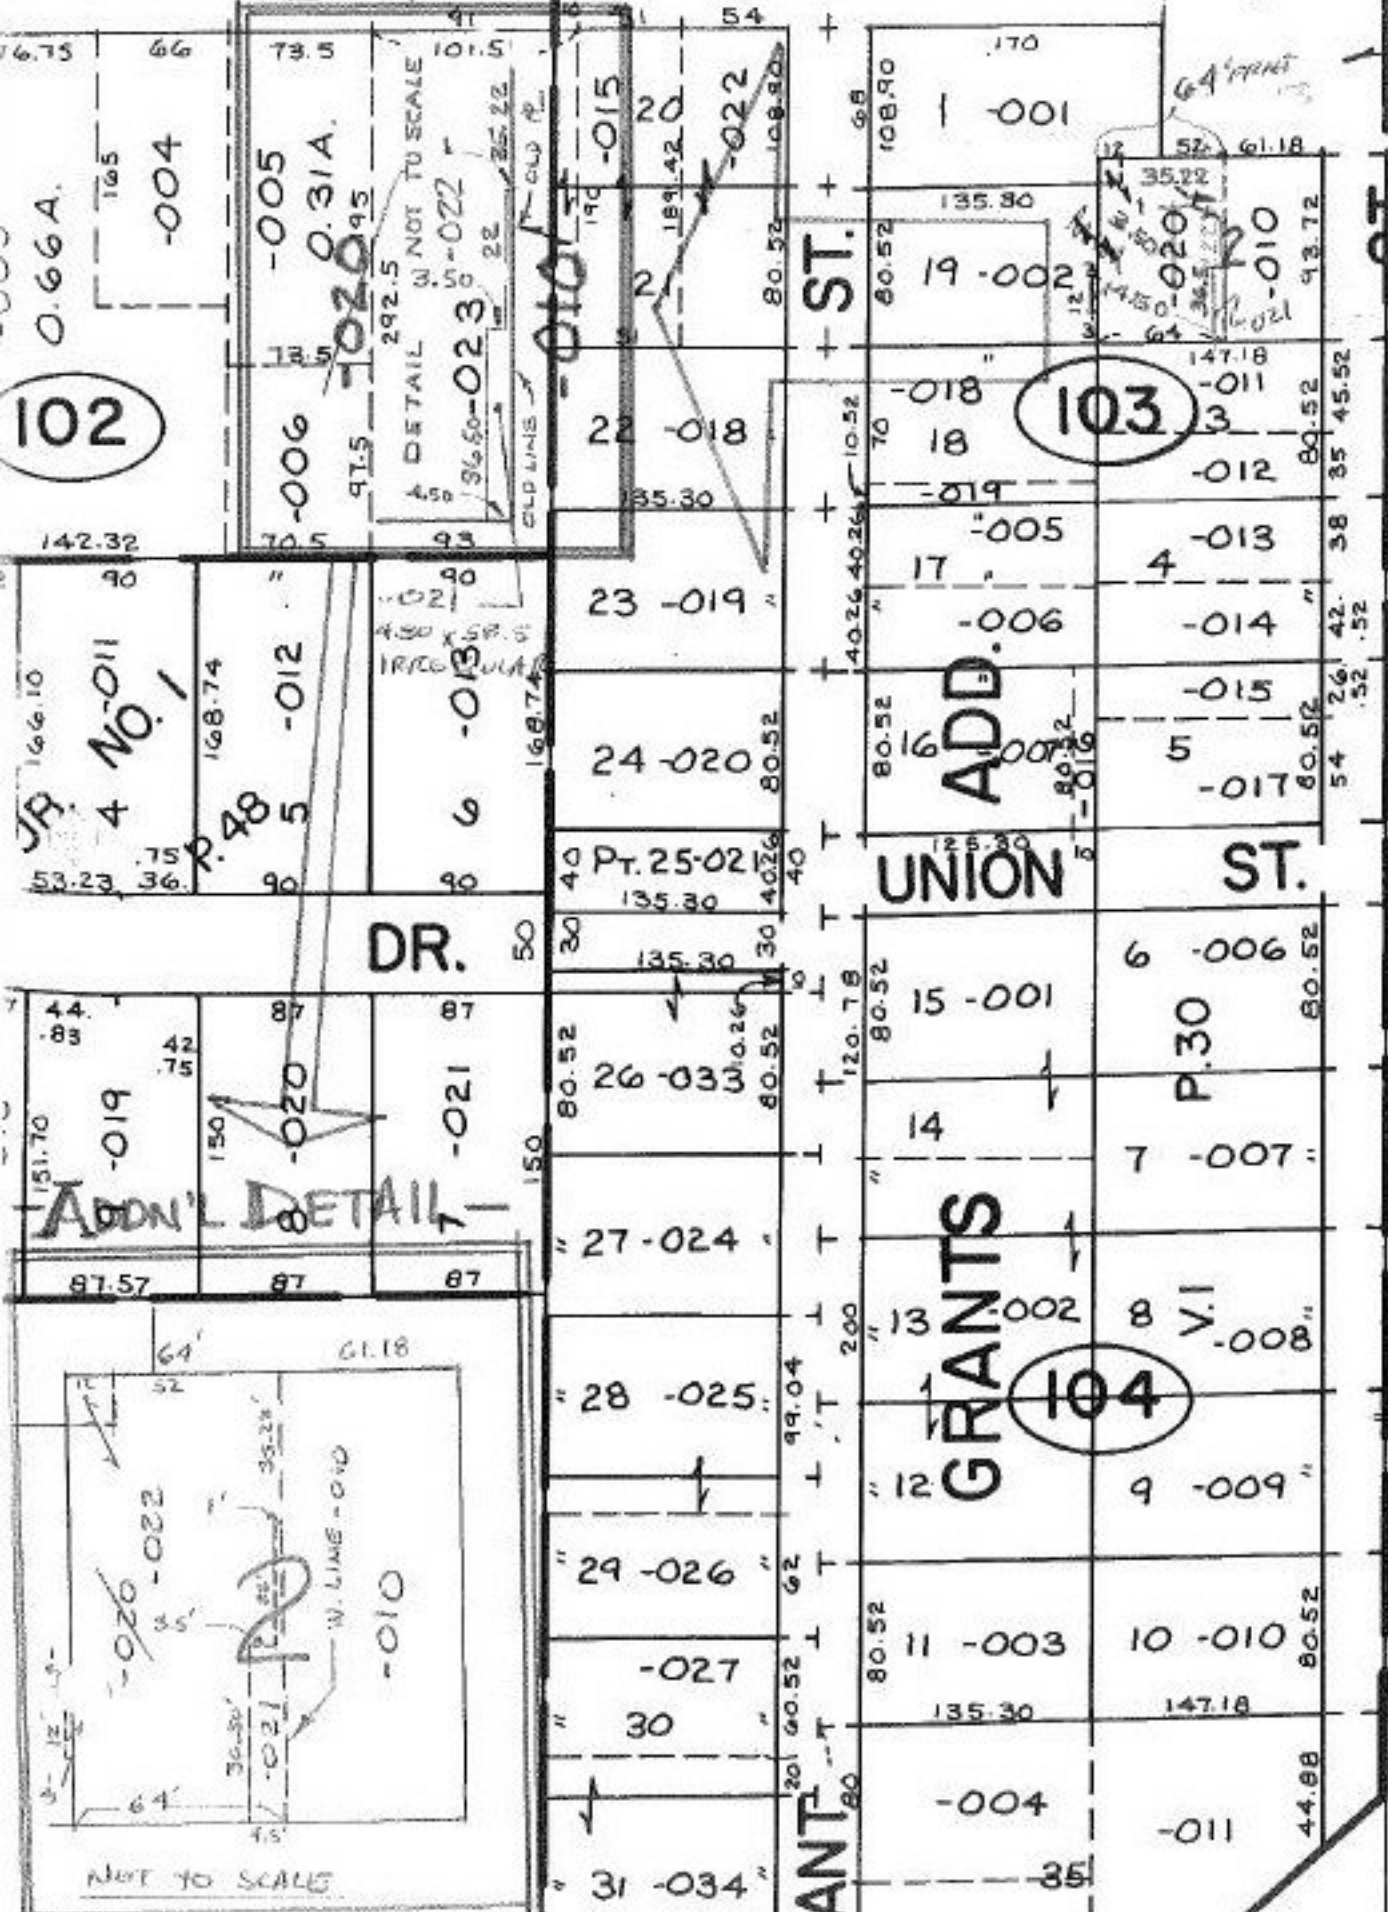

APR 14 1992  
 #19623

~~#19273A~~

APPROVED  
 LORAIN CO.  
 MAP DEPT.  
 DATE 10/15/91  
 PAGE 15-00-056-B  
 BY T. McPherson  
 VOID AFTER 19273A  
 #19623