


SELL 7-00-047-A

18.20 A.
1.94 A.
16.26 A.

WOODS
PHASE 2 OF
INDUSTRIAL
VOL. 37 PG. 8

3 -094
-077
18.20 A.
16.26 A.

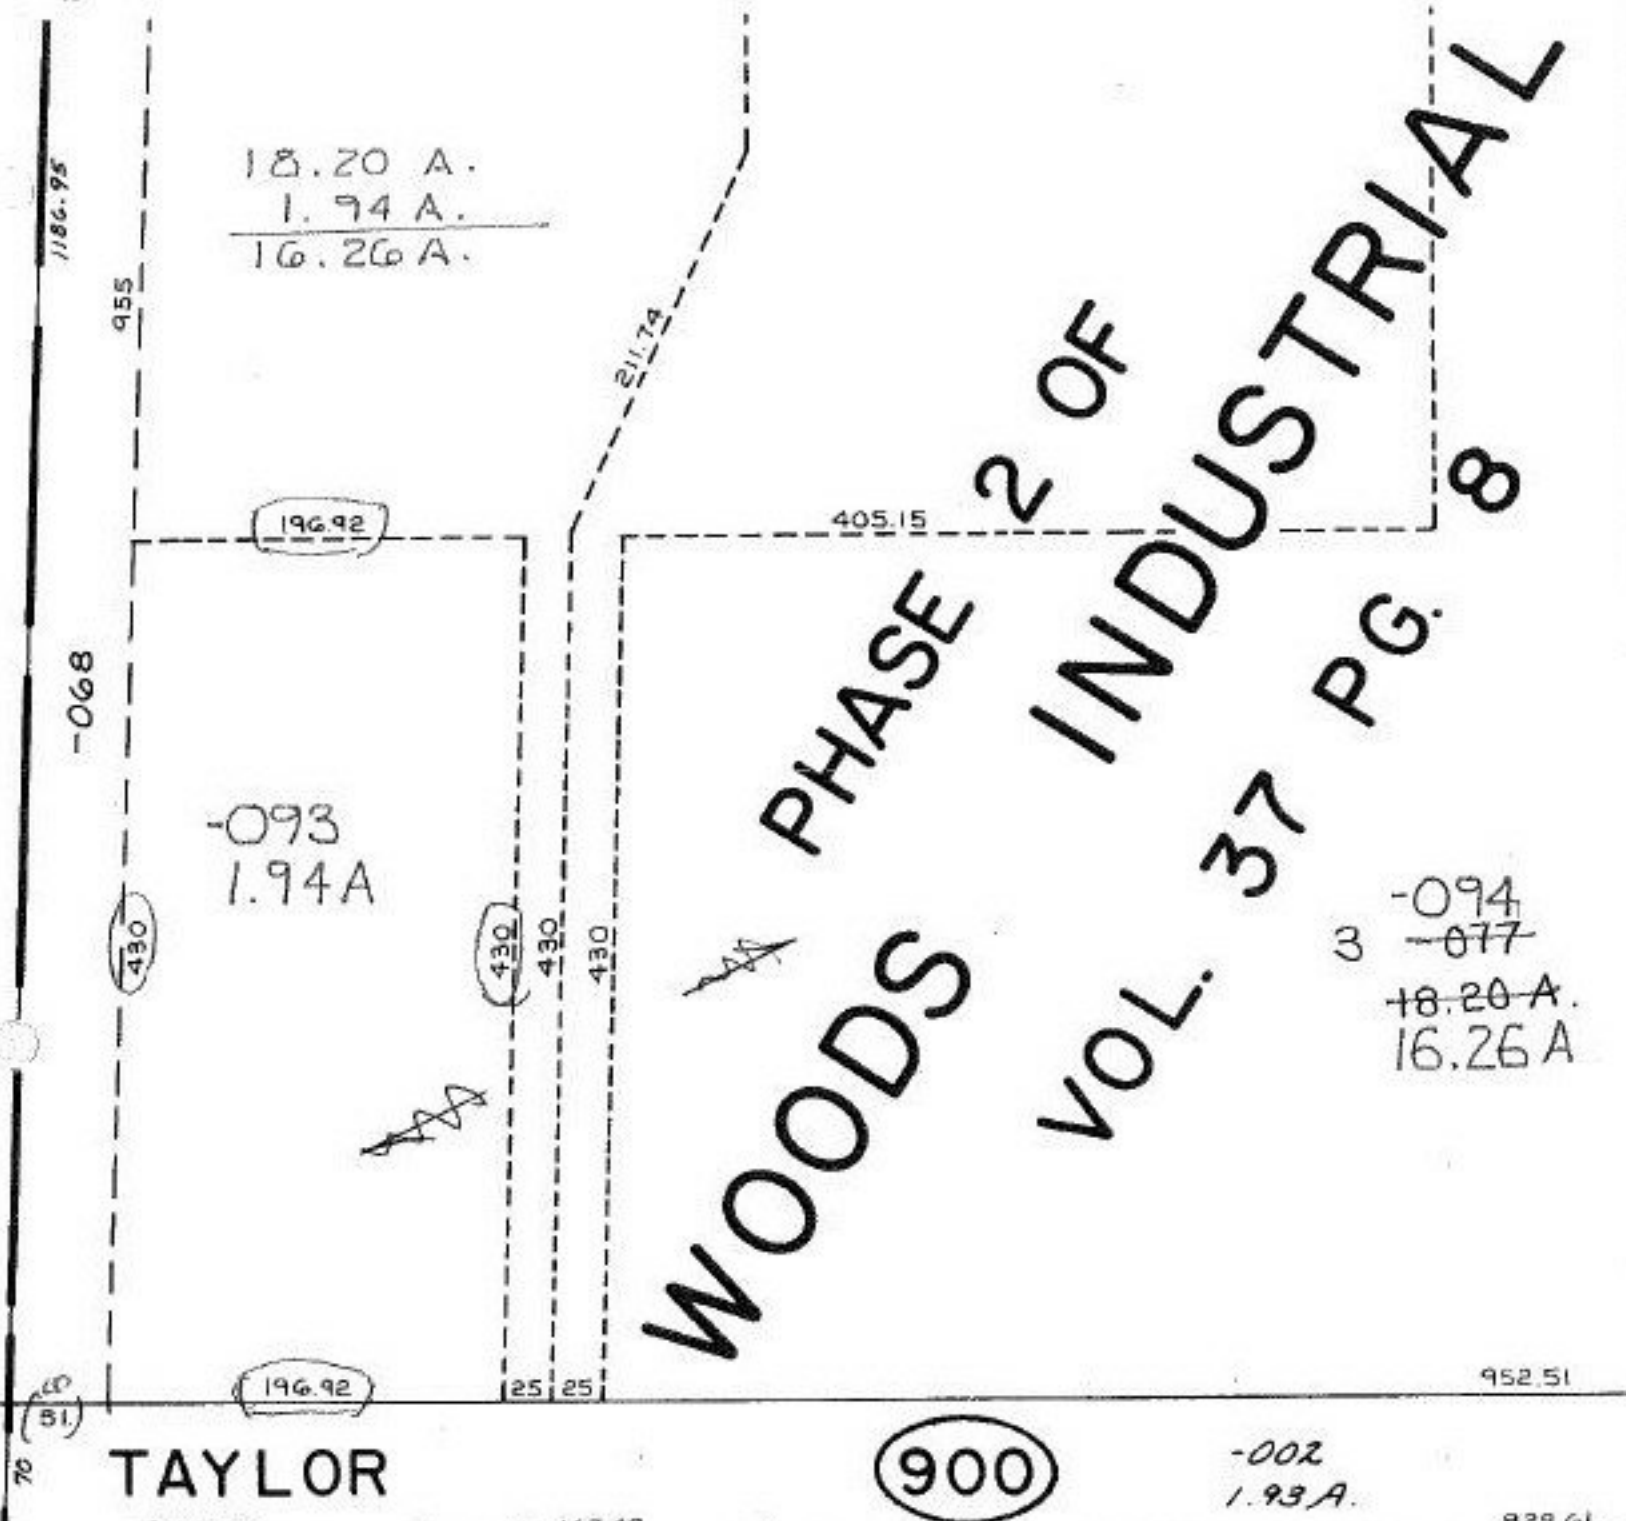

TAYLOR

7-00-047-000- PRIOR INST. 1273/328
SURVEYED BY: KS ASSOC. DAVID ELMELL REG.
SURVEYOR

C-1: INF.

1205.15
7/15/92
19628

APPROVED
LORAIN CO.
MAP DEPT.
DATE 10-28-91
PAGE 7-00-047B
CAROLYN
FRANCIS
19628

4 -074
12.87 A.

-073
2.04 A.

529.55

29.37

529.87