
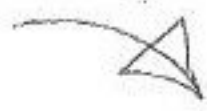


-008 0.08 A
 -005 0.20 A
 0.28 A

90° 56'
 91°

WEST RIVER RD.

? No. 

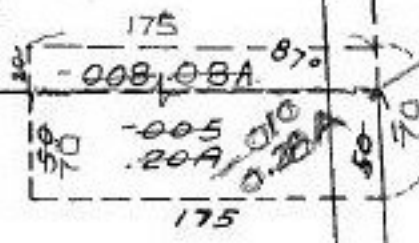

06-22-014-102-005
 -008
 PRIOR INST'S DV. 1163 / 183
 DV. 817 / 274

SEE 6-11

COMBINATION

660.0

R. R. 100

-001 691±

-006 52 A.

(102) 281.50

-007
 1.07 A

1/6/92
 19631
 APPROVED
 LORAIN CO.
 MAP DEPT.
 DATE 10-29-91
 PAGE 6-10
 BY CAROLYN
 FRANCIS
 VOID
 AFTER # 19631