


SEE I-00-017-A

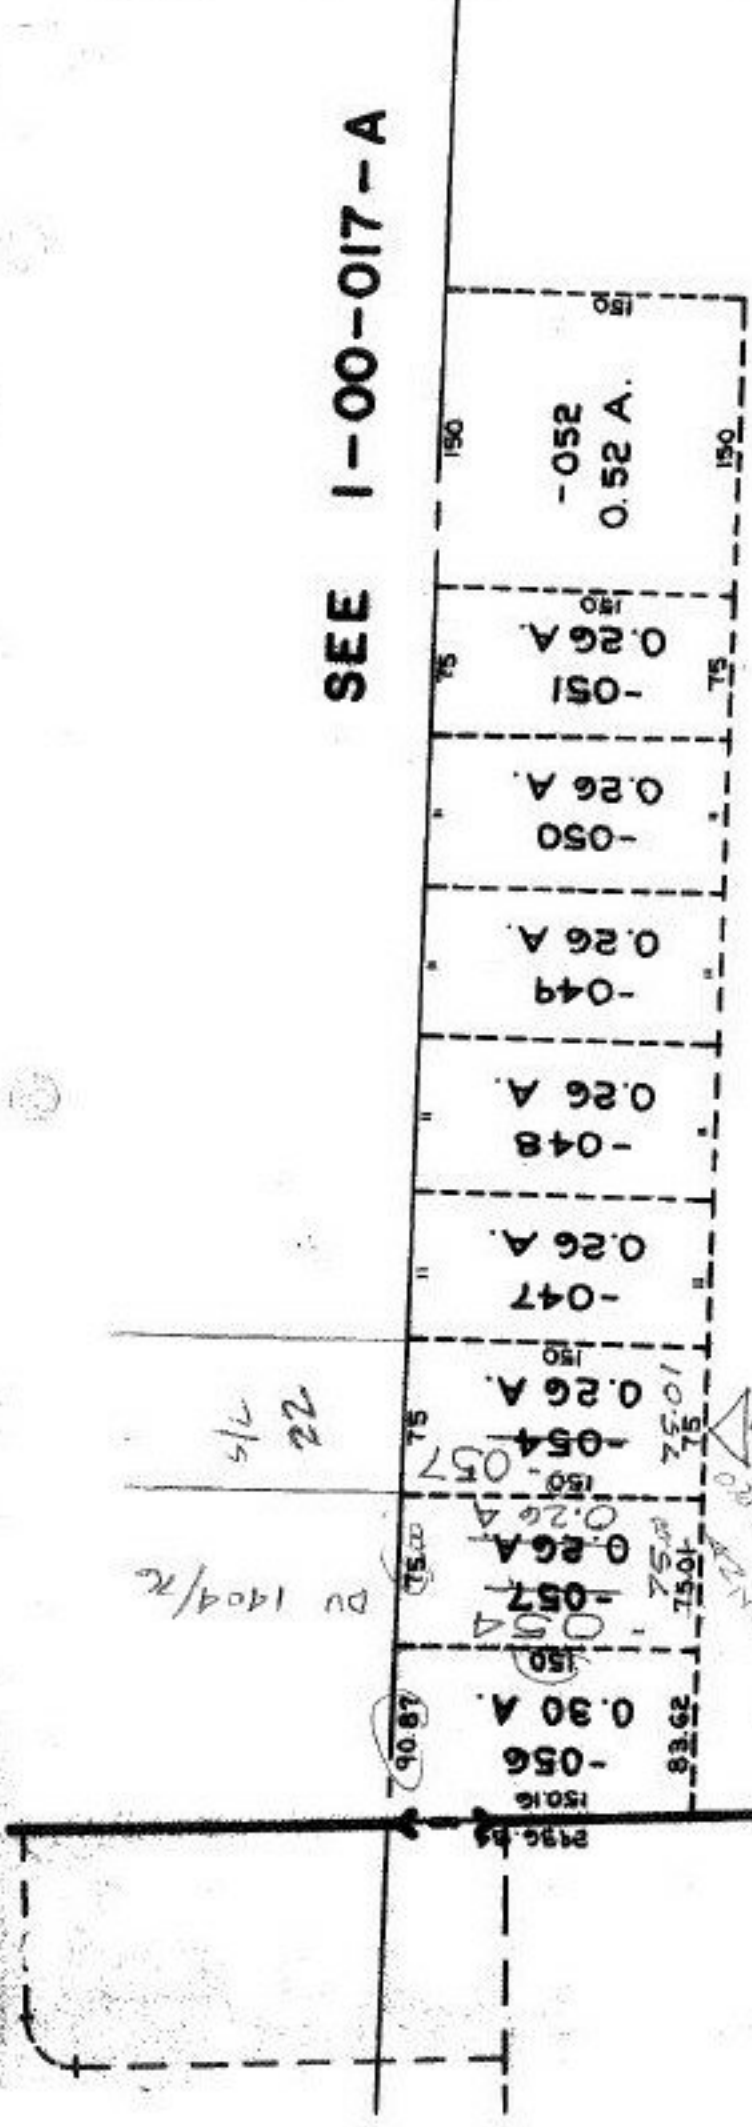


SEE DV O.R. 45/481  
PARCEL DRAWN WRONG PLACE

11/8/91

19640-A -046  
15.33 A.

APPROVED
LORAIN CO.
MAP DEPT.
DATE 10-30-91
PAGE 00-032-A
BY CAROLYN FRANCIS
VOID AFTER

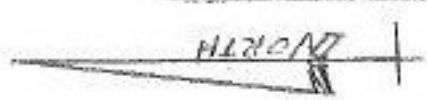

~~19640~~

APPROVED
LORAIN CO.
MAP DEPT.
DATE 10-30-91
PAGE
BY
VOID AFTER

MAP CORRECTION

5.09 A.