


SEE I-J

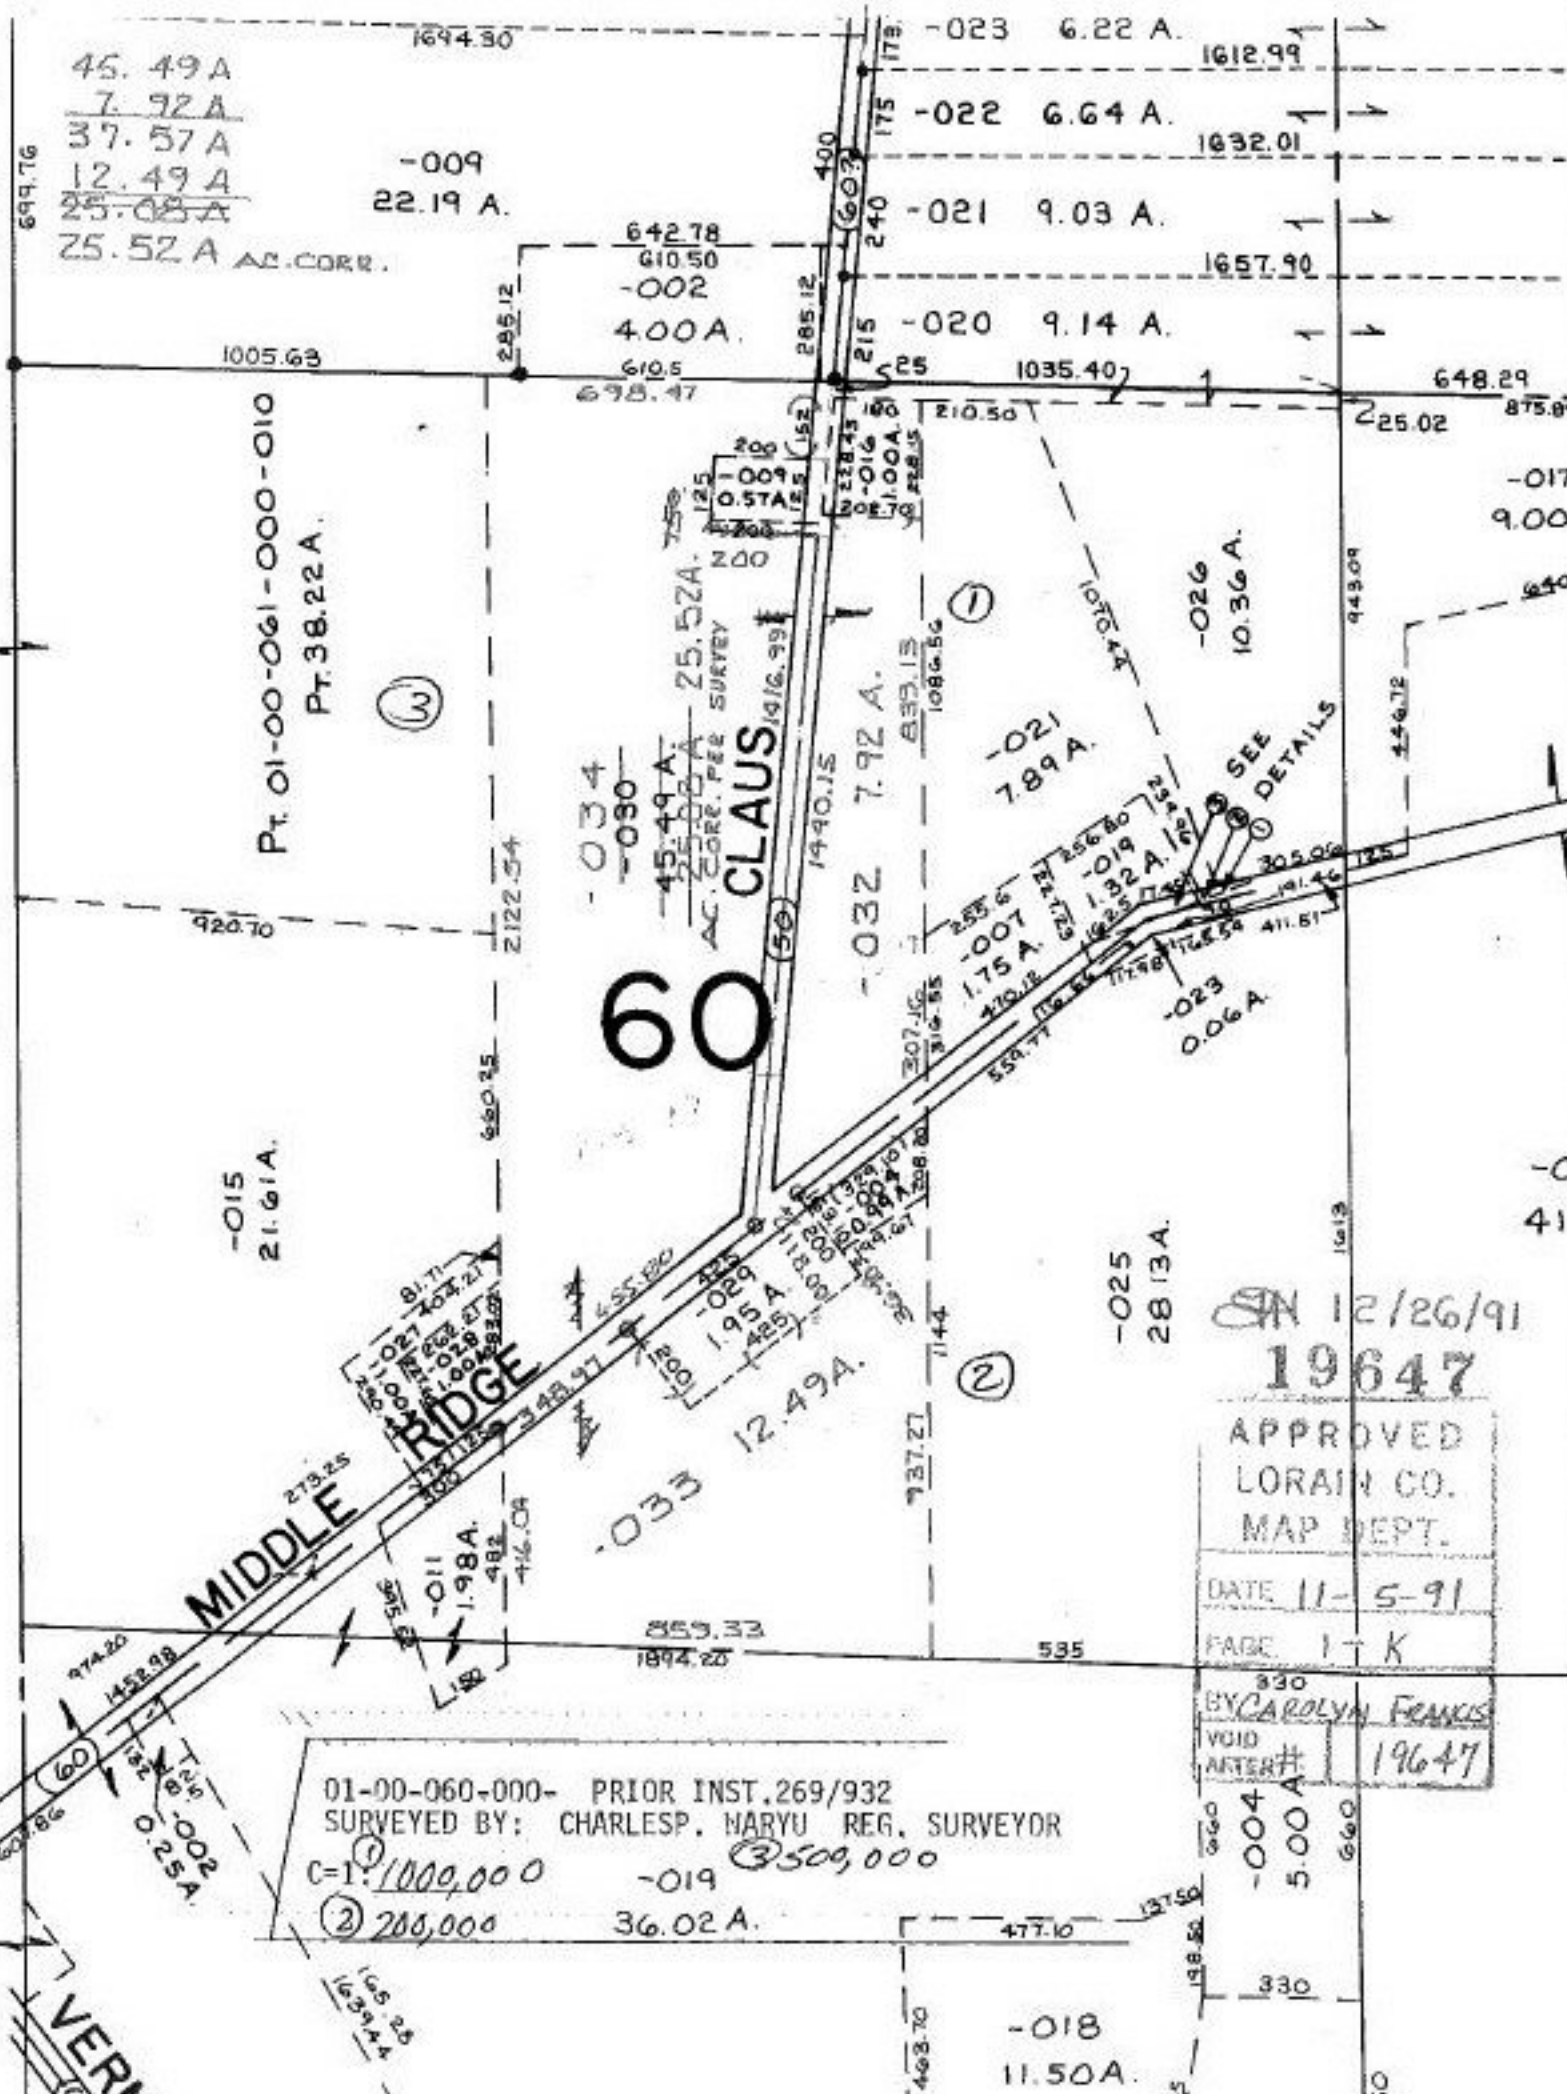

45.49 A  
 7.92 A  
 37.57 A  
 12.49 A  
 25.08 A  
 25.52 A AC. CORR.

-009  
 22.19 A.

642.78  
 610.50  
 -002  
 400 A.

-023 6.22 A.  
 -022 6.64 A.  
 -021 9.03 A.

-020 9.14 A.

Pt. 01-00-061-000-010  
 Pt. 38.22 A.

60  
 CLAUD

45.49 A  
 25.08 A  
 AC. CORR. FEE SURVEY

-032 7.92 A.

-021 7.89 A.

-026 10.36 A.

-023 0.06 A.

-015 21.61 A.

-C 41.

MIDDLE RIDGE

-033 12.49 A.

-025 28.13 A.

SN 12/26/91  
 19647

APPROVED  
 LORAIN CO.  
 MAP DEPT.

DATE 11-5-91

PAGE 1-K

BY CAROLYN FRANCIS  
 VOID AFTER # 19647

01-00-060-000- PRIOR INST. 269/932  
 SURVEYED BY: CHARLES P. NARYU REG. SURVEYOR

① 1,000,000  
 ② 200,000  
 -019 36.02 A.  
 ③ 500,000

-018 11.50 A.

VERMILION