

105.98
191.24

161A
746.60
-004
1.44A
815.32


80.96
RD.

1965

~~-002~~
~~29.36A~~

-035
28.36A

PS-HC-C
&&

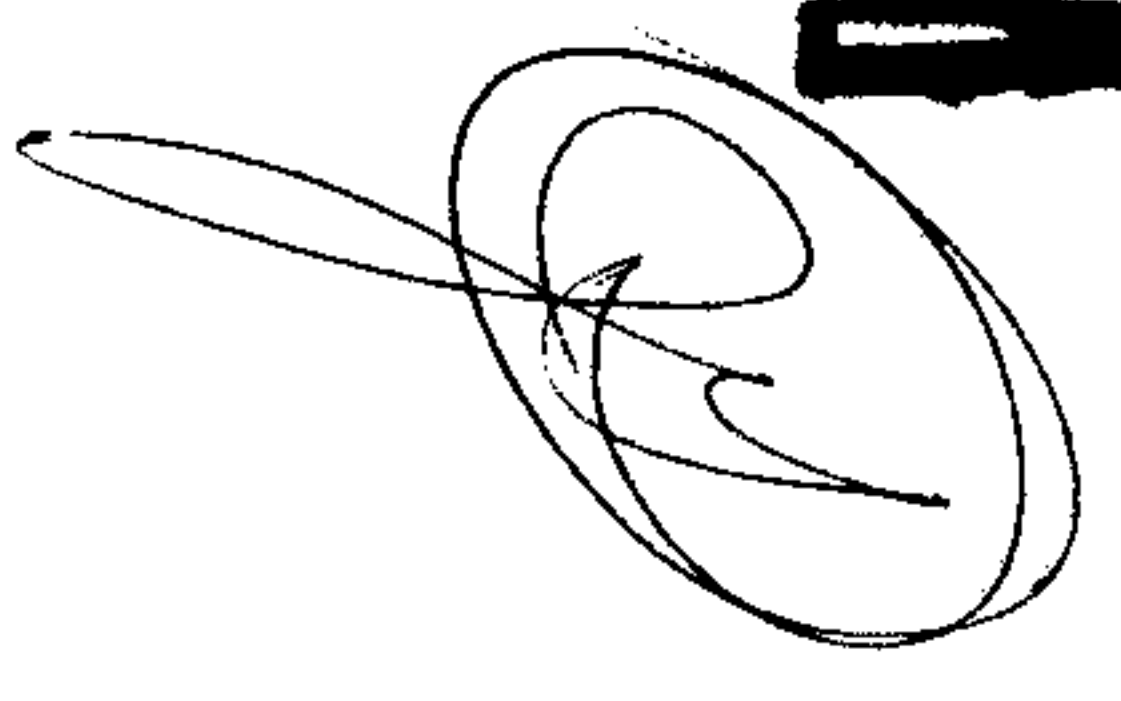

APPROVED
LORAIN CO.
MAP DEPT.
DATE 7-23-68
BY <i>[Signature]</i>
9-00-100-AB
9/27/68 RPK

1887.24

160.02

272.22

272.22

160.02

-034
1.00A