


MILLS - AVON

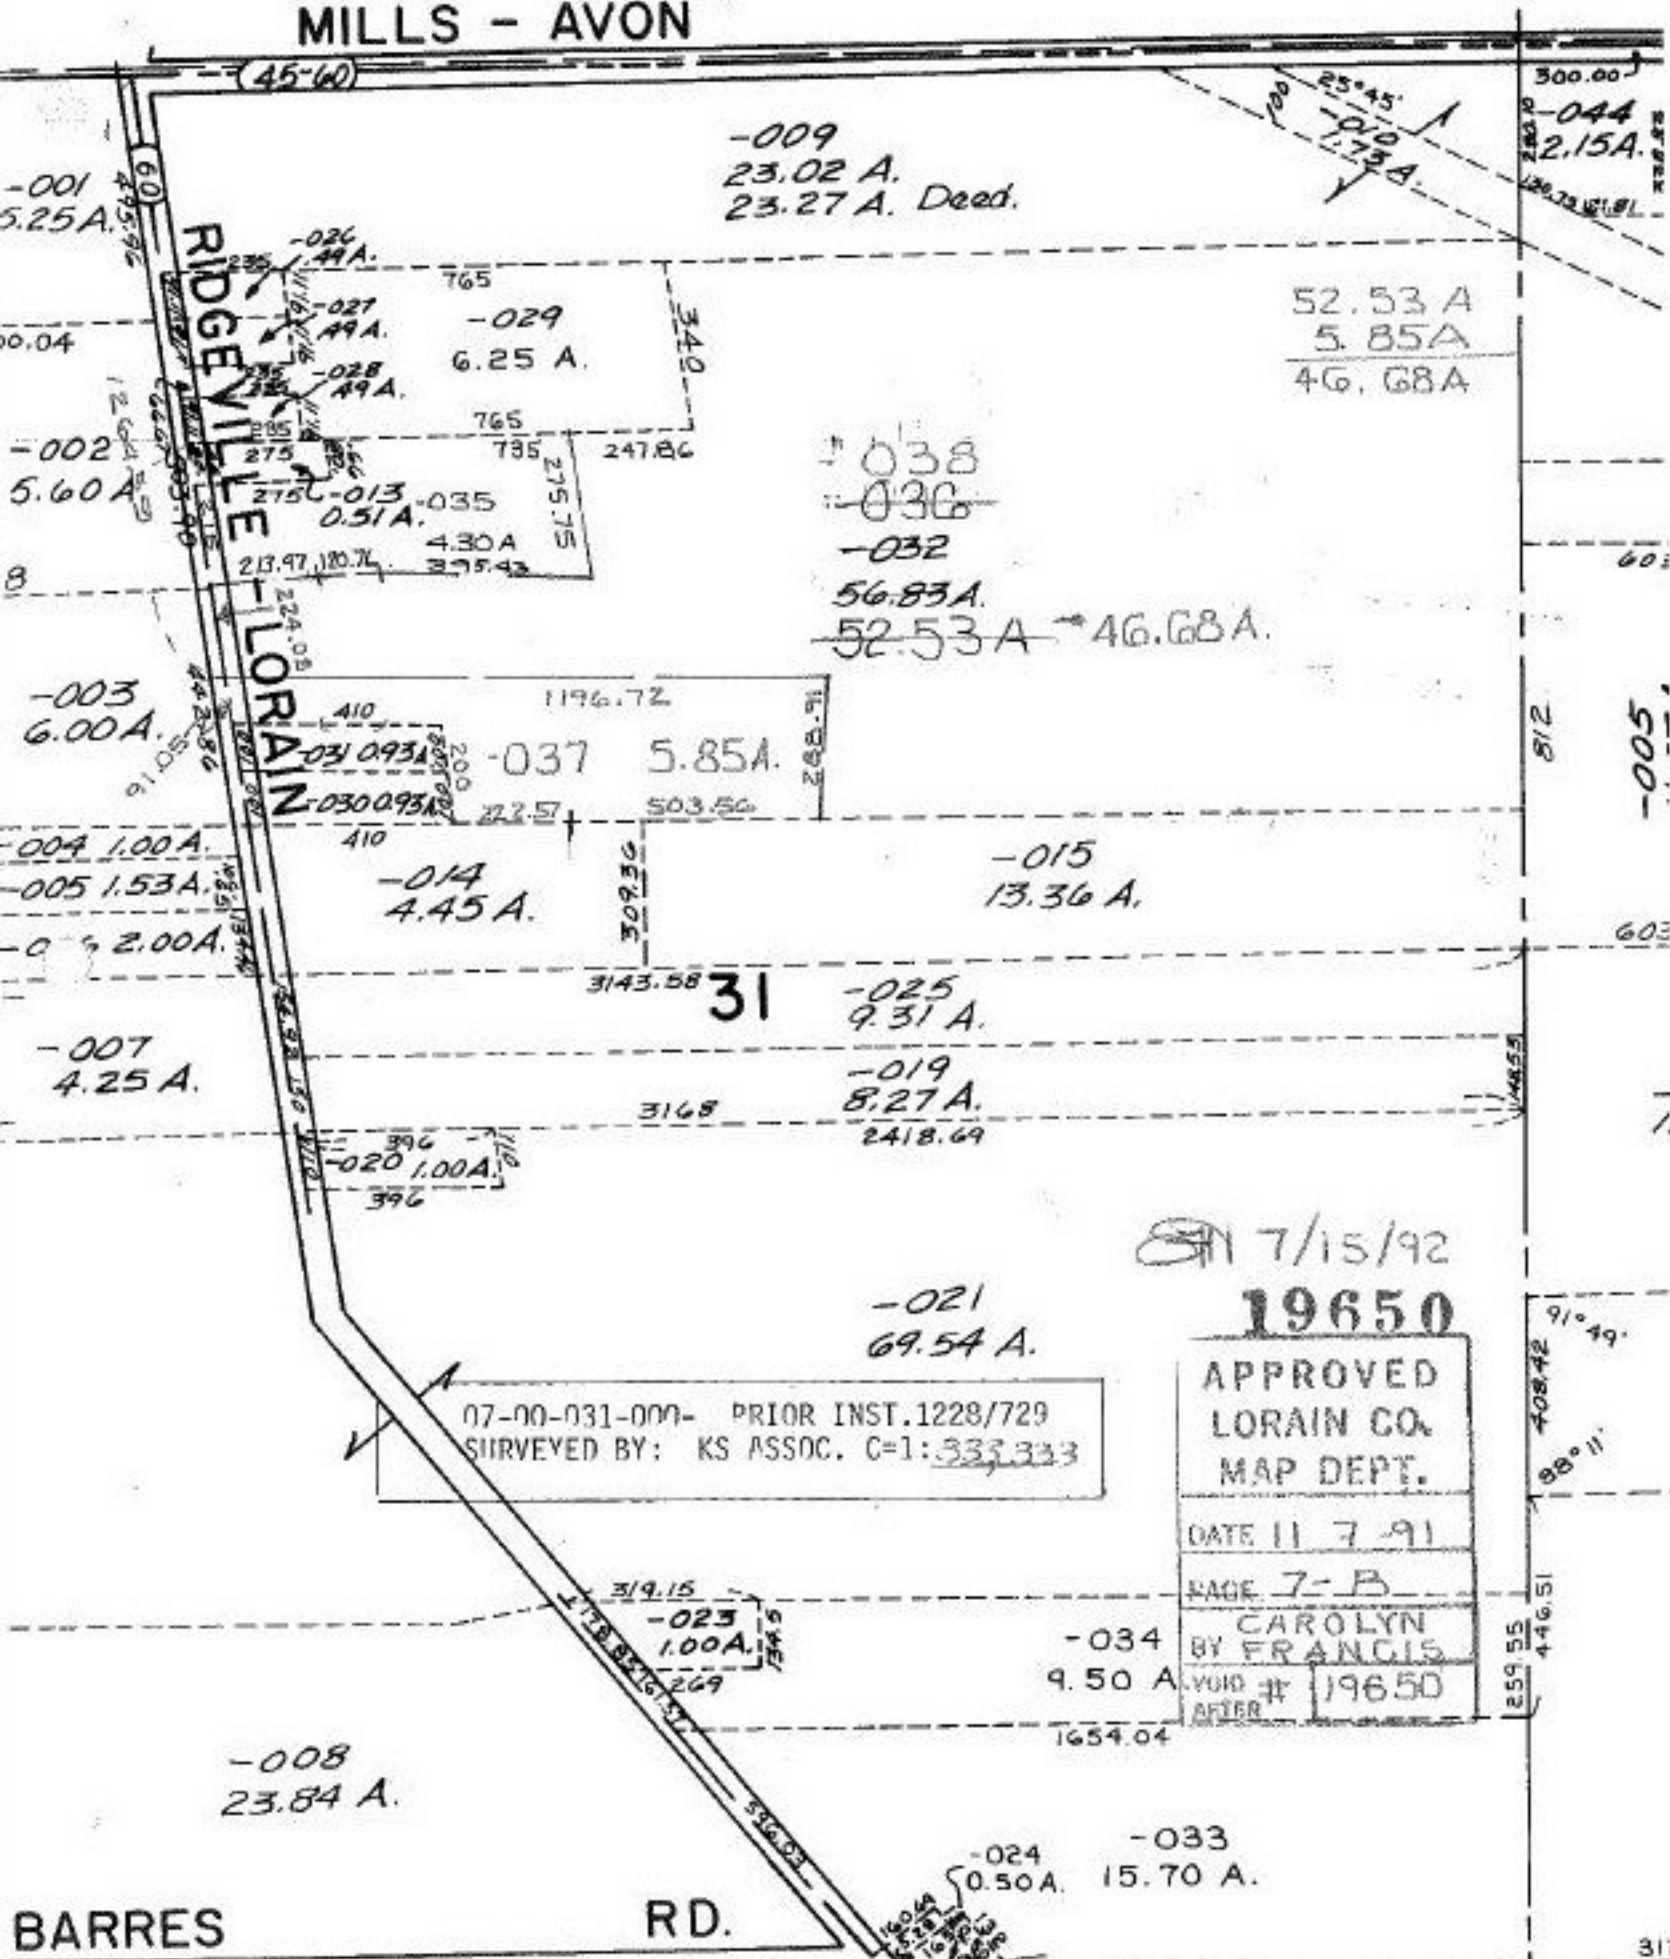

07-00-031-007- PRIOR INST. 1228/729  
 SURVEYED BY: KS ASSOC. C=1:333,333

7/15/92  
**19650**

APPROVED  
 LORAIN CO.  
 MAP DEPT.  
 DATE 11 7 91  
 PAGE 7-B  
 CAROLYN  
 BY FRANCIS  
 VOID # 19650  
 AFTER

BARRES

RD.