


-003  
4.11A.

307.56

543.84  
~~543.84~~

96.32

96.62

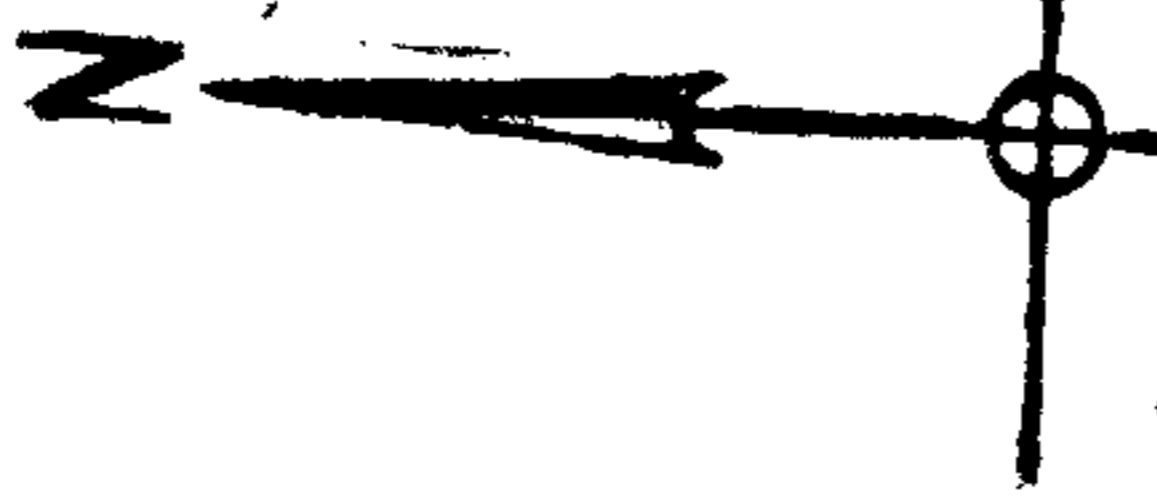

1 IN. = 100 FT

101

-002  
10.96A.

-007  
1.09A.

479.26

510.47

1.16A.

-005

540.35

~~-006~~  
~~3.84A.~~ -008  
2.75A.

1971

7-14-81/8.S.

<b>APPROVED</b>
<b>LORAIN CO.</b>
<b>MAP DEPT.</b>
DATE 7-23-68
5-00-094-A.
BY <i>H. Hubert</i>

389  
307  
275

9/25/68 RK.

60'  
RD.

100

20.40

19.60

122

158.45

119

554.4

97.45

70