


EDINA - NORWALK

SEE D.V. 48
D.V. 49

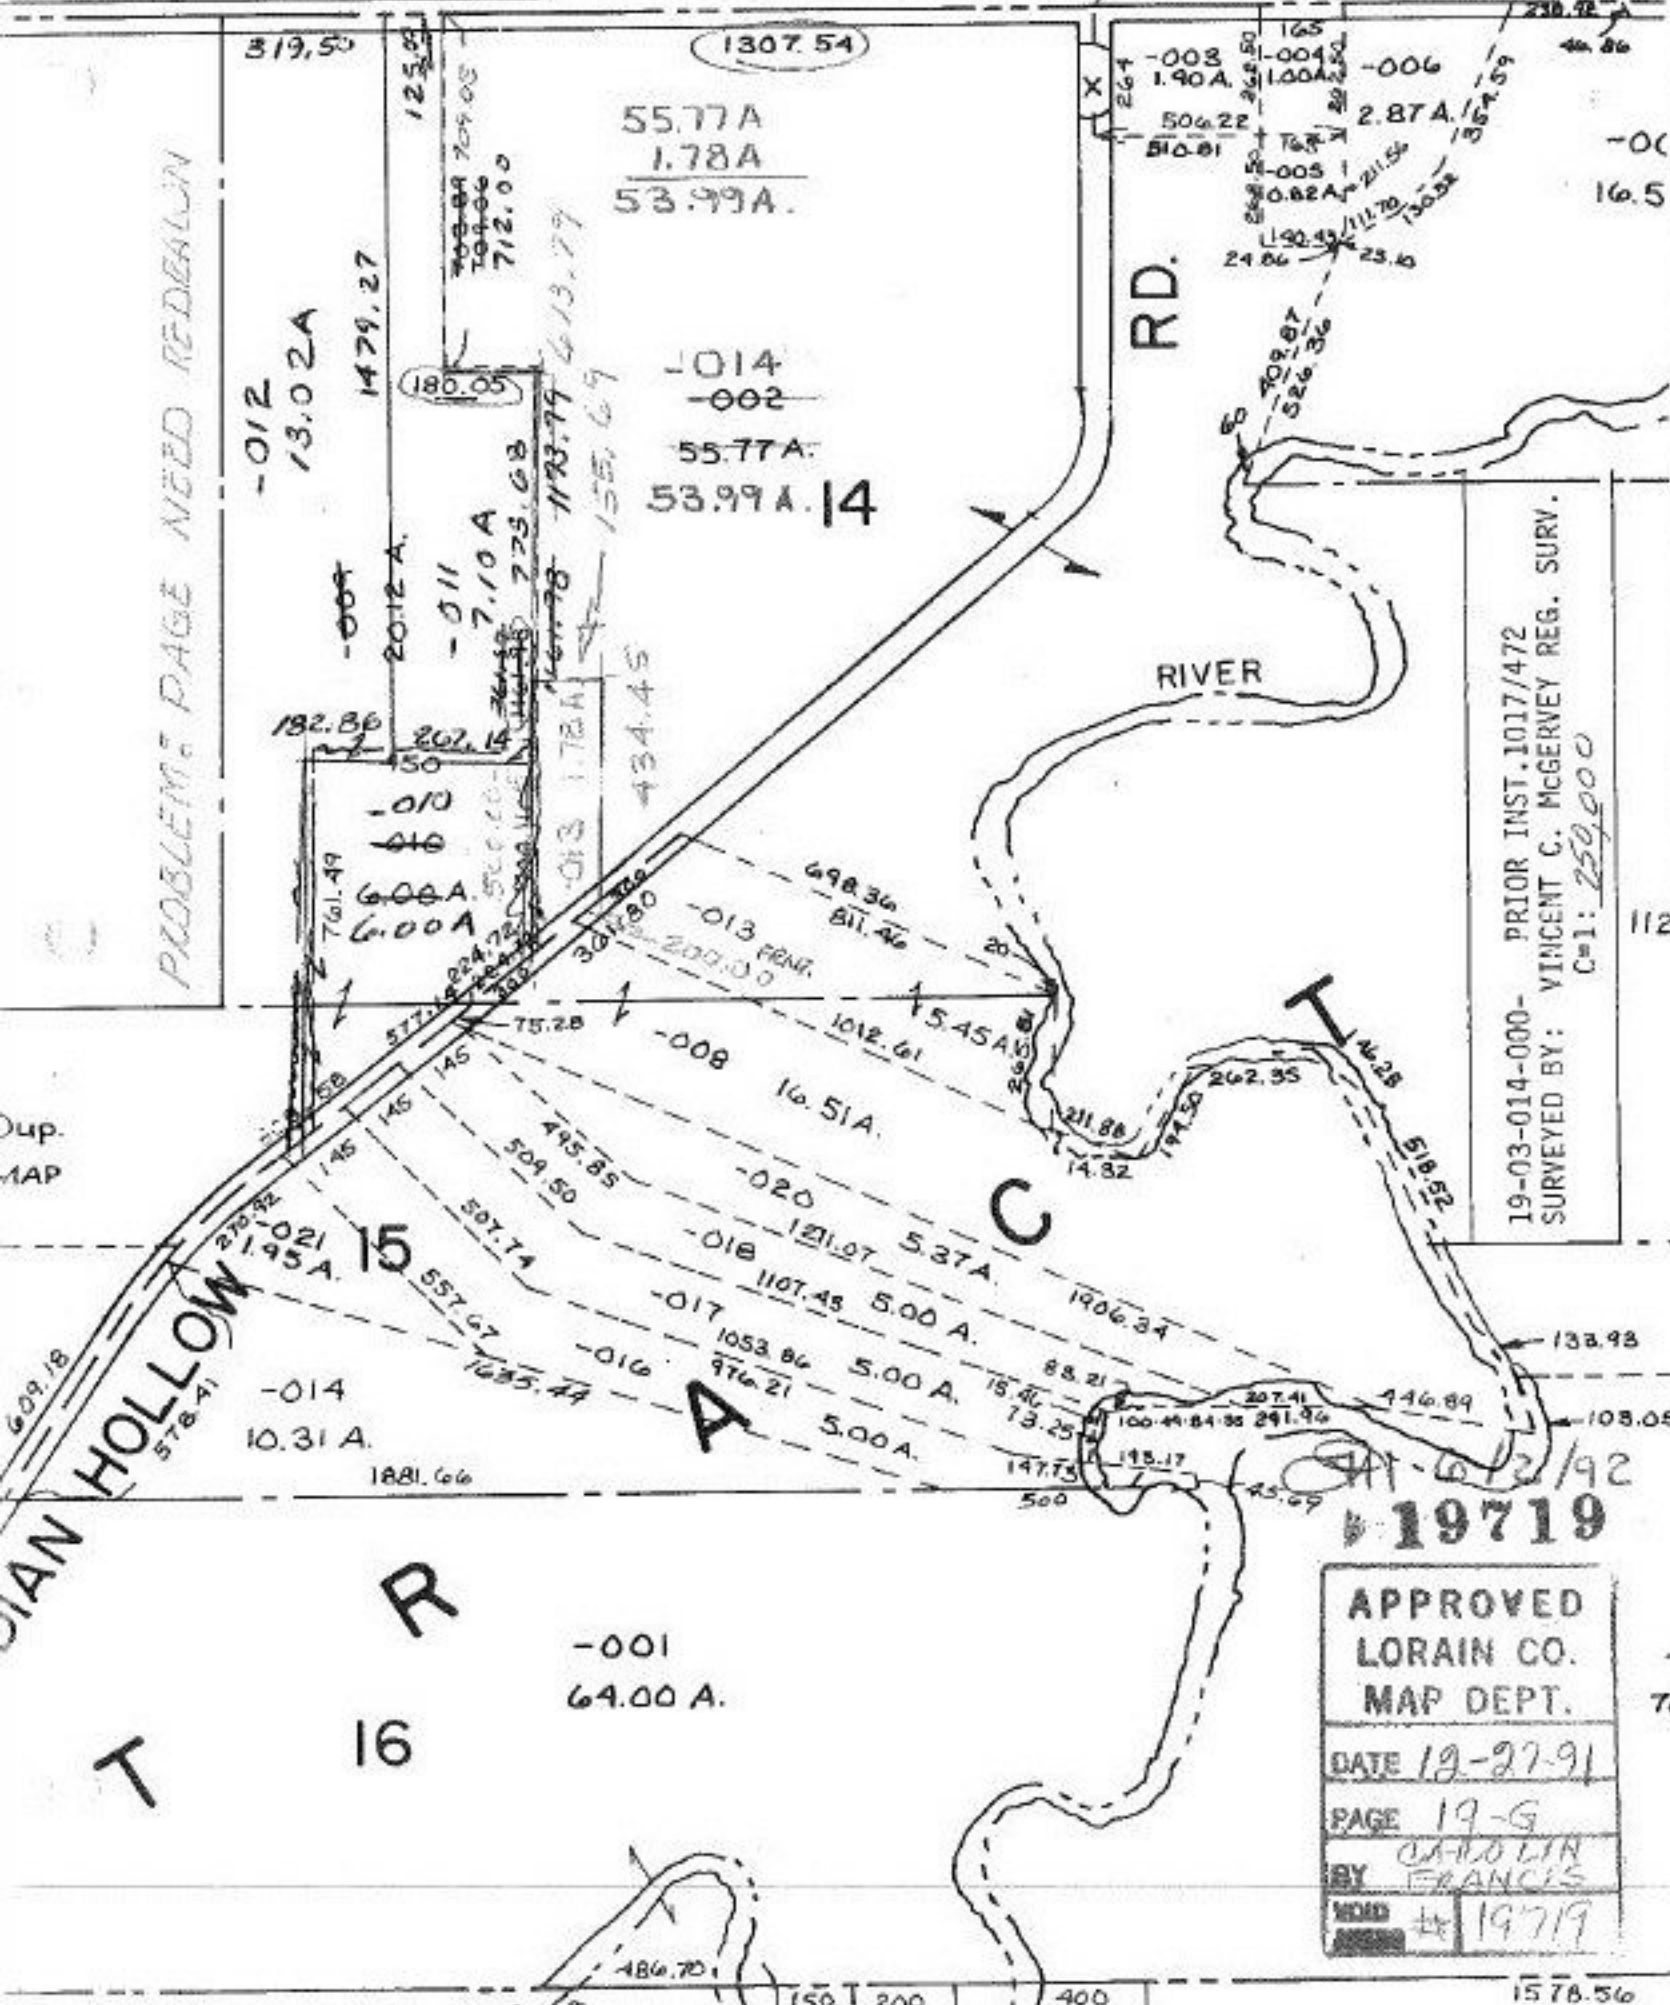

PROBLEM: PAGE NEED REDEALIN

19-03-014-000-
PRIOR INST. 1017/472
SURVEYED BY: VINCENT C. MCGERVEY REG. SURV.
C=1: 250,000

APPROVED
LORAIN CO.
MAP DEPT.
DATE 12-27-91
PAGE 19-G
BY CAROLIN
FRANCIS
ROAD # 19719

T

R

16

A

C

T

112

70

150 | 200 | 400

1578.56