


SEE 12-00-041-B

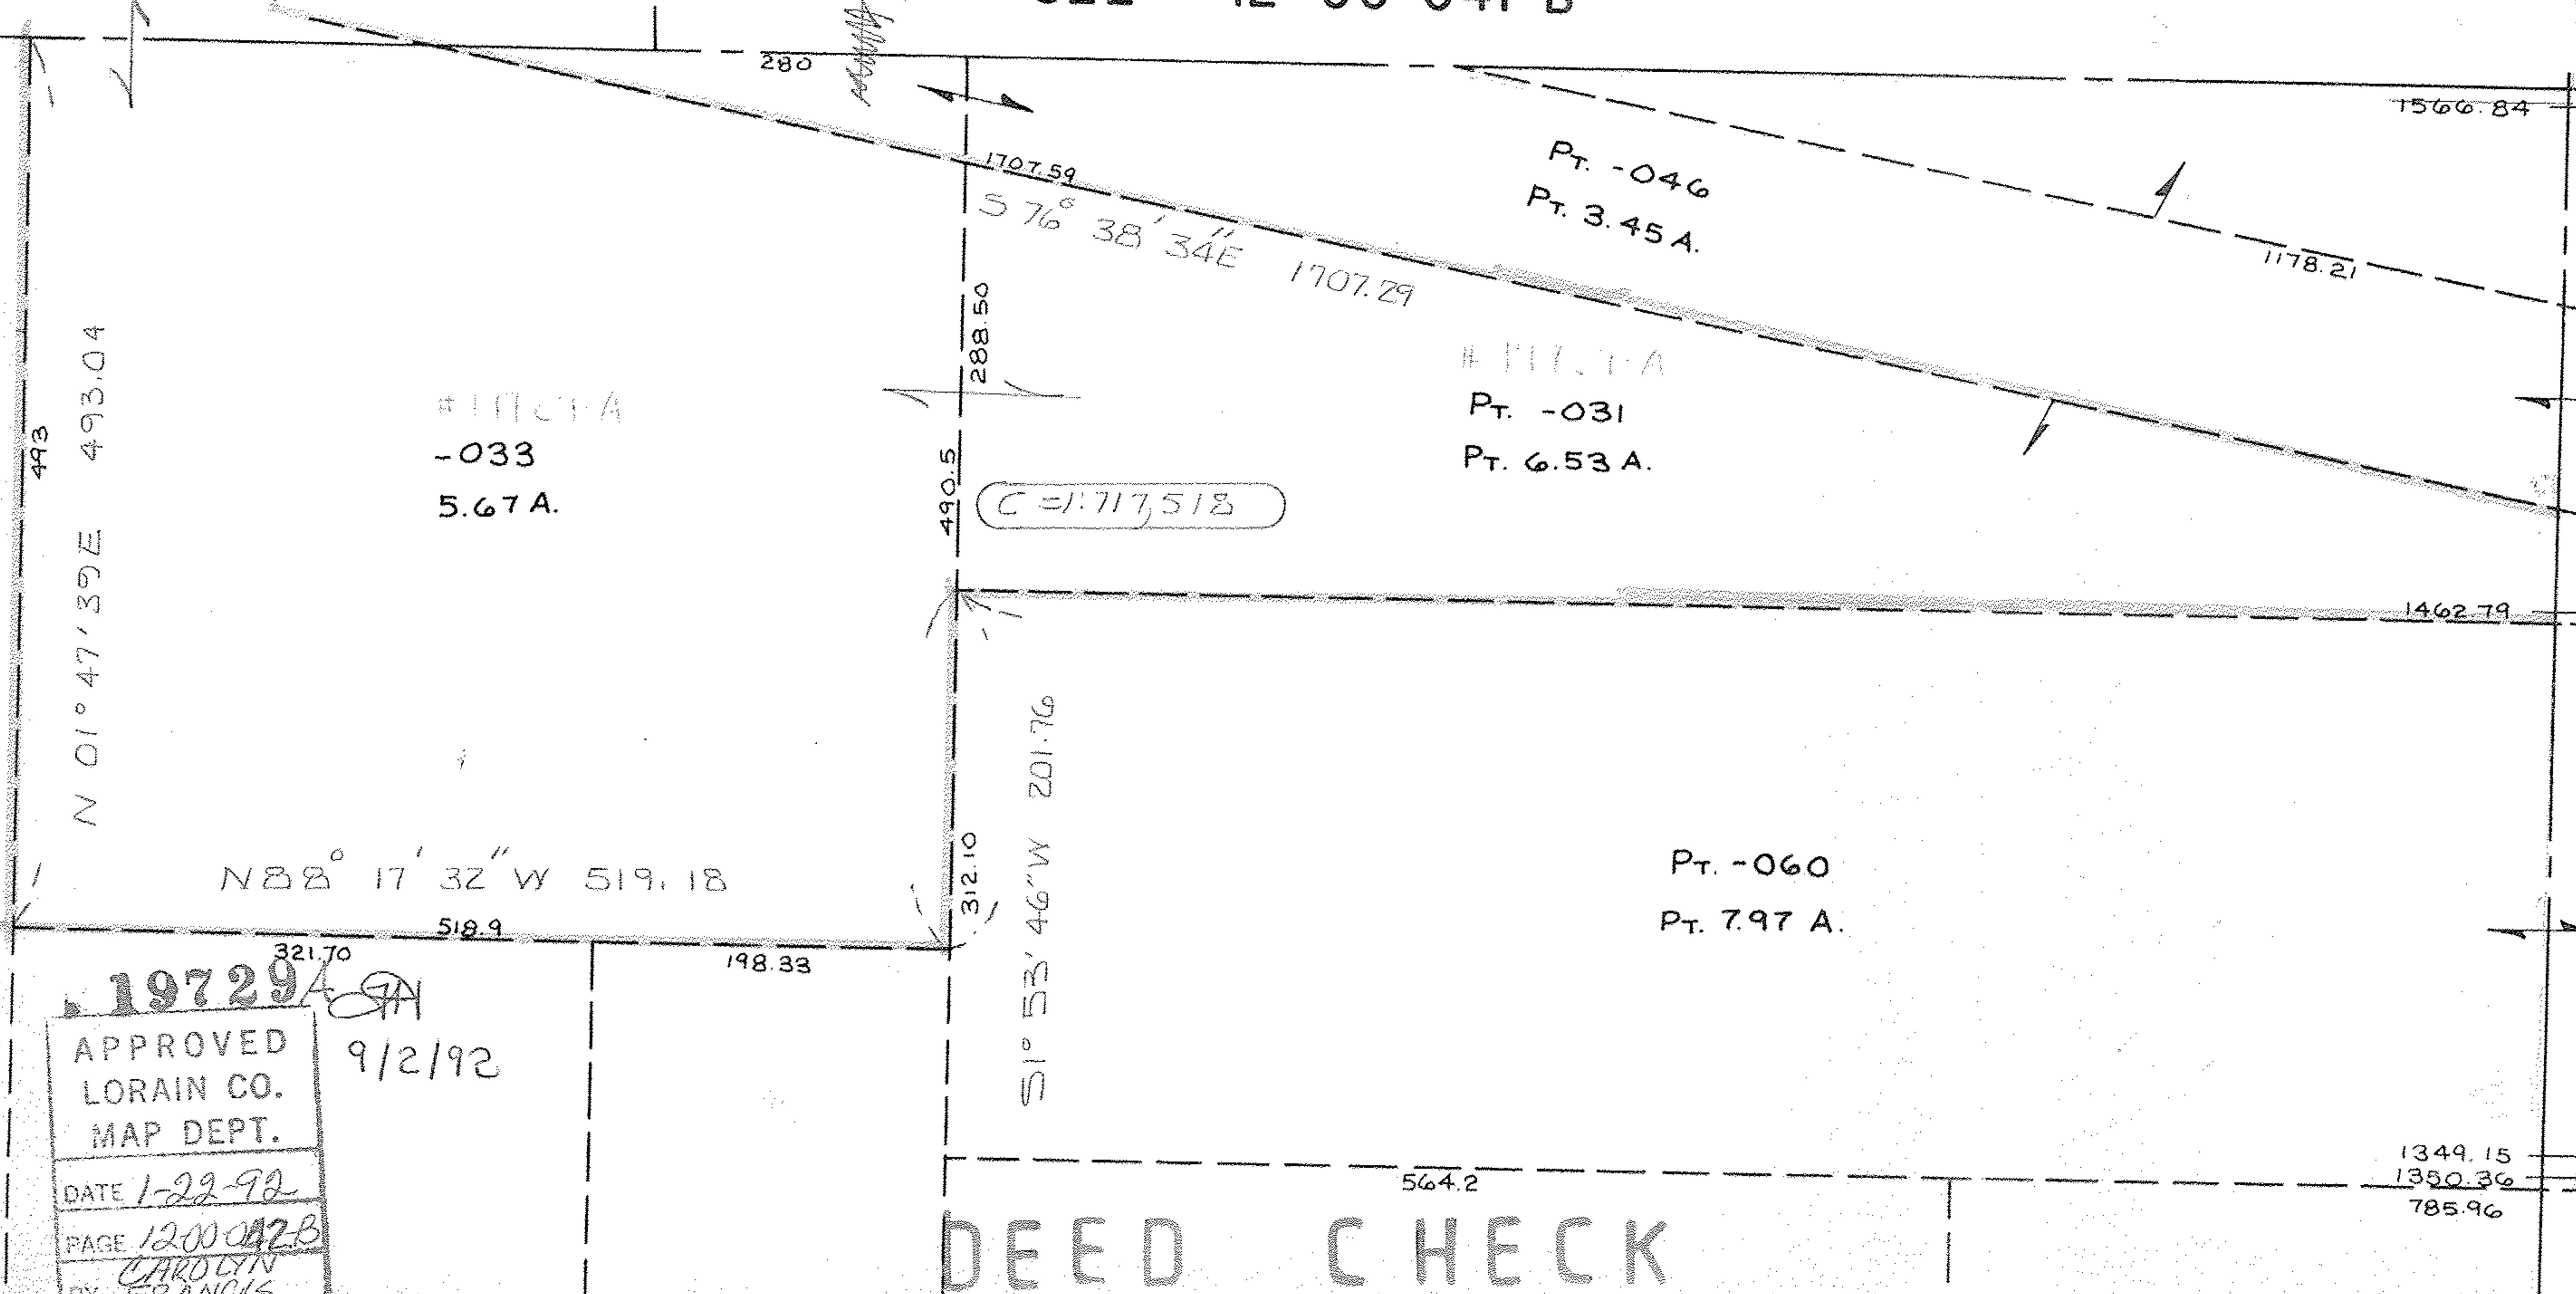

DEED CHECK

19729A  
 APPROVED  
 LORAIN CO.  
 MAP DEPT.  
 DATE 1-22-92  
 PAGE 1200042-B  
 BY CAROLYN FRANCIS  
 VOID AFTER # 19729A  
 9/2/92

17707