


COM 13.

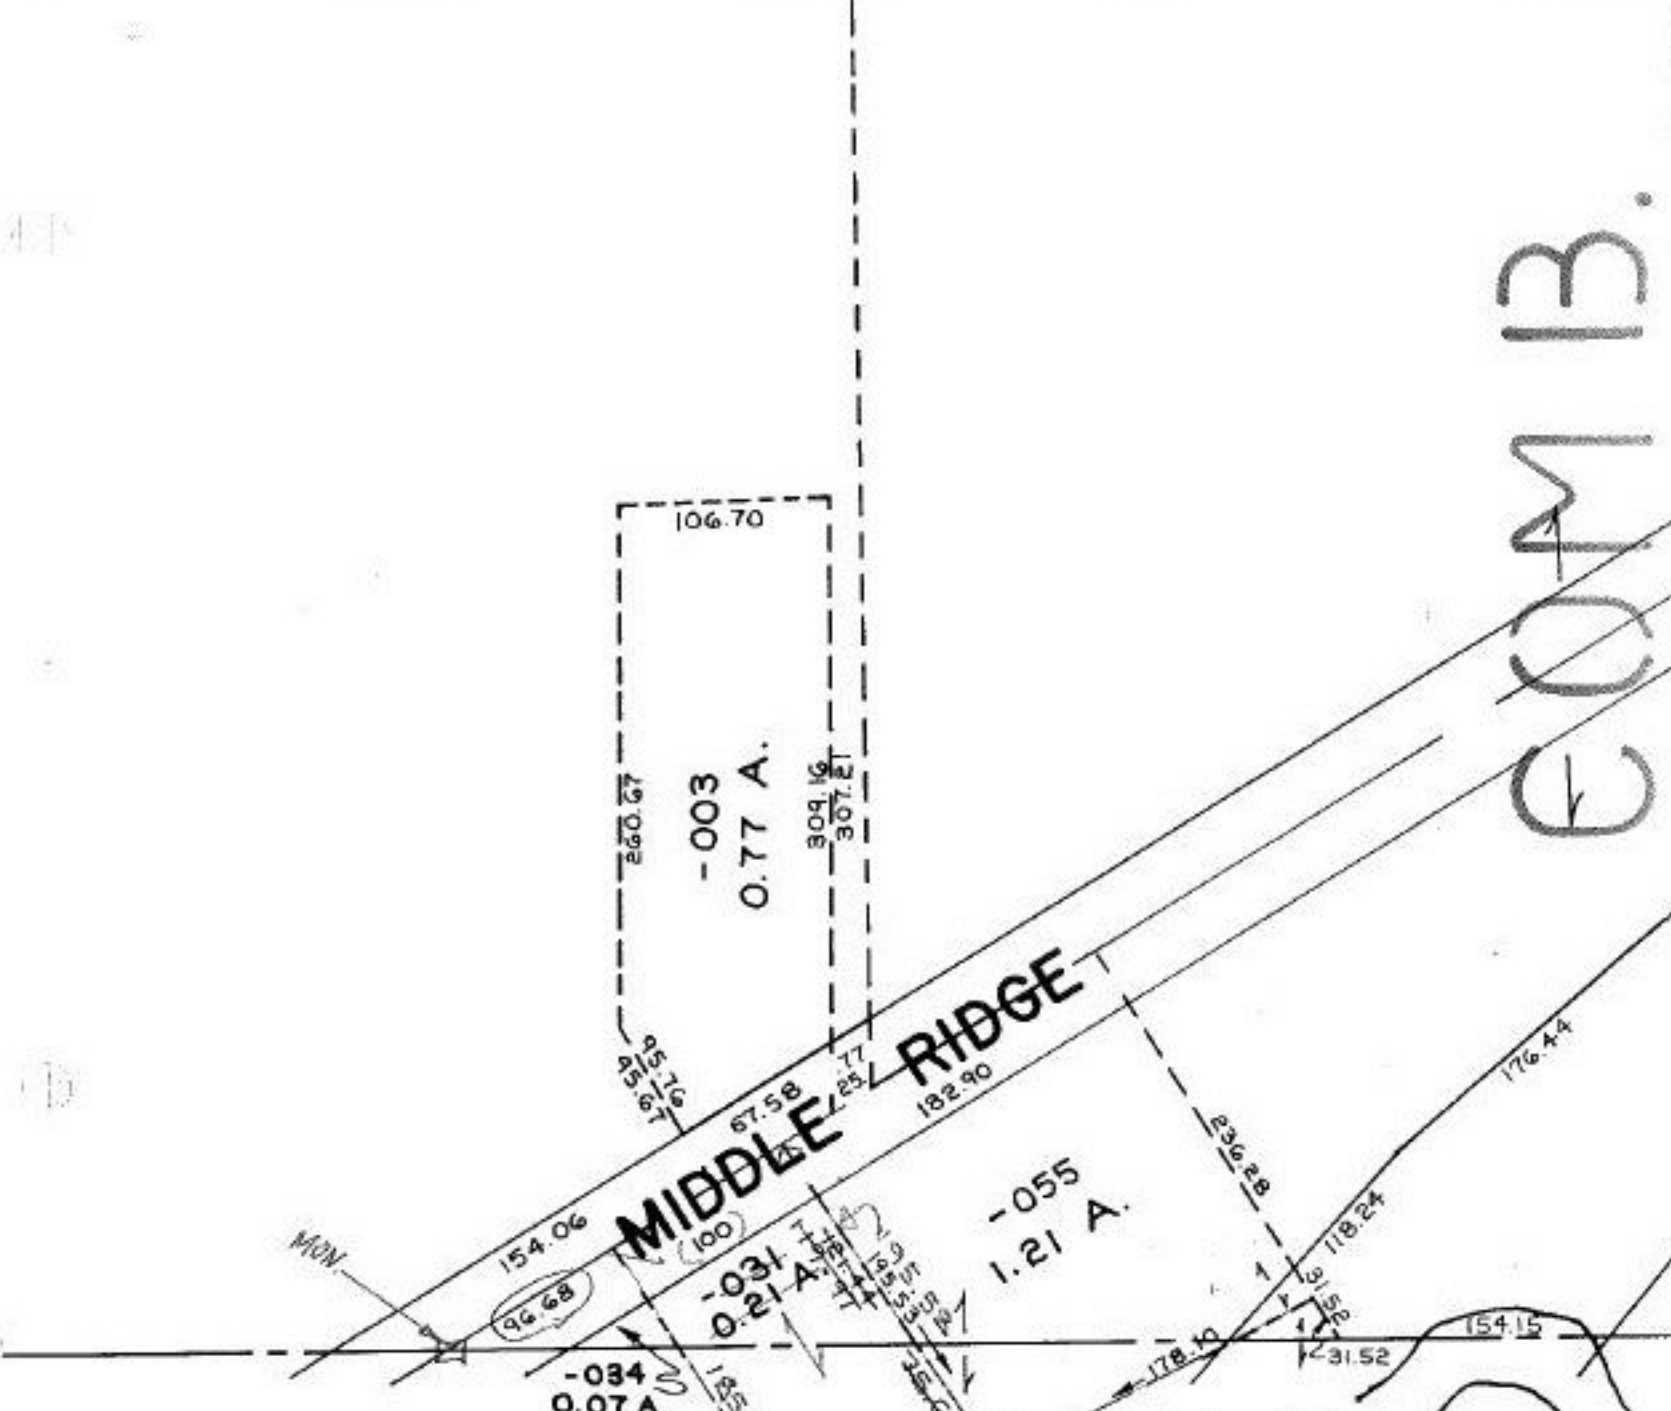

Pt. 0500-056-000-049
 Pt. 0.45A
 AC. PER SURVEY 0.44A

SEE 5-00-056-A
 4/18/92
 19729

05-00-056-000- 05-00-057-000- PRIORITY INST: _____
 BOUNDARY DESCRIPTION PER KSA.

APPROVED
 LORAIN CO.
 MAP DEPT.
 DATE 2-19-92
 PAGE 5-00-057-A
 CAROLYN
 BY FRANKS

AMHERS

SCALE: 1" = 100'

OF LOT 57