

ADD DISTANCES TO
TAX MAP

DISTANCES PER SURVEY BY WESTERN
RESERVES ENG.



DEED CHECK


N 01° 53' 40\"/>

C = 1:134,356

9/2/92

19729A

APPROVED
LORAIN CO.
MAP DEPT.

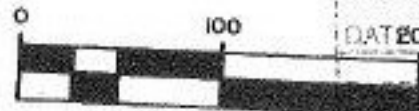

DATE 1-22-92
17-00-041-B
BY CAROLYN FRANCIS
19729A

COLUMBIA T