


NEW LONDON LAFAYETTE RD.  
**NEW LONDON - LAFAYETTE** 170.00

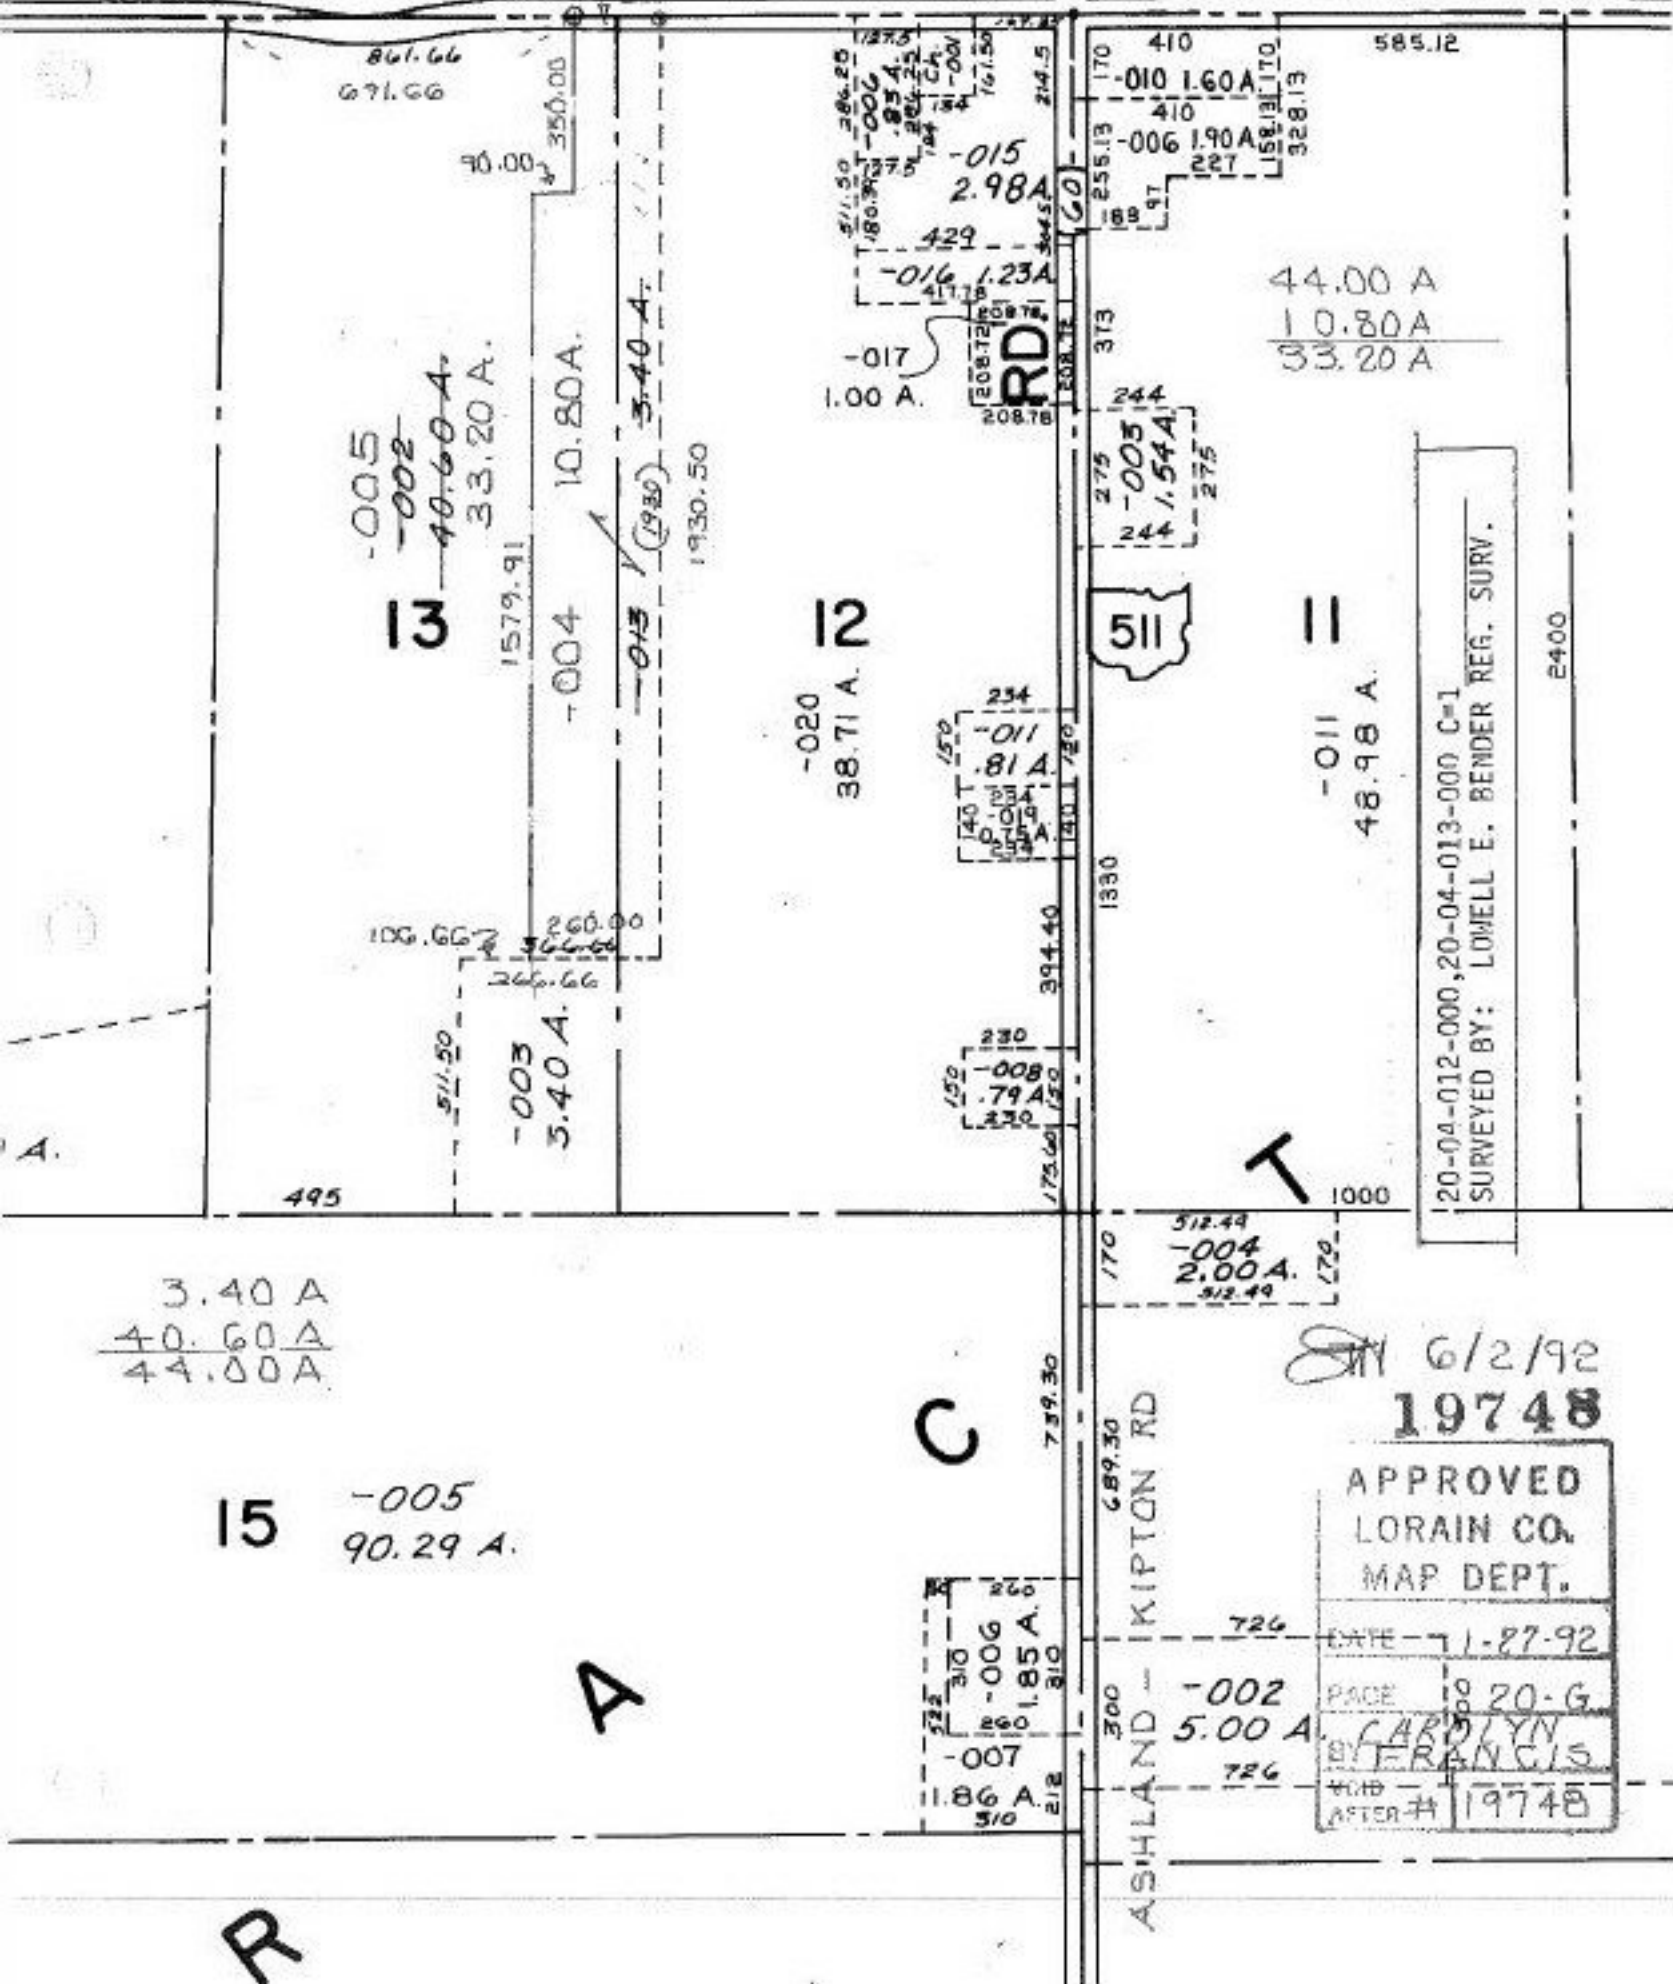

3.40 A  
 40.60 A  
 44.00 A

15 -005  
 90.29 A.

12  
 -020  
 38.71 A.

13  
 -005  
 -002  
 40.60 A  
 33.20 A  
 1579.91  
 -004  
 10.80 A.

44.00 A  
 10.80 A  
 33.20 A

11  
 -011  
 48.98 A.

6/2/92  
**19748**

APPROVED  
 LORAIN CO.  
 MAP DEPT.

DATE - 7-27-92  
 PAGE 20-G  
 BY CAROLYN  
 FRANCIS  
 #19748

20-04-012-000, 20-04-013-000 C=1  
 SURVEYED BY: LOWELL E. BENDER REG. SURV.



C

A

R