




SEE 2-02-026.

DESCRIPTION

DESCRIBE P.P. NO. 02-02-027-107-009  
O.R. VOL. 236/13

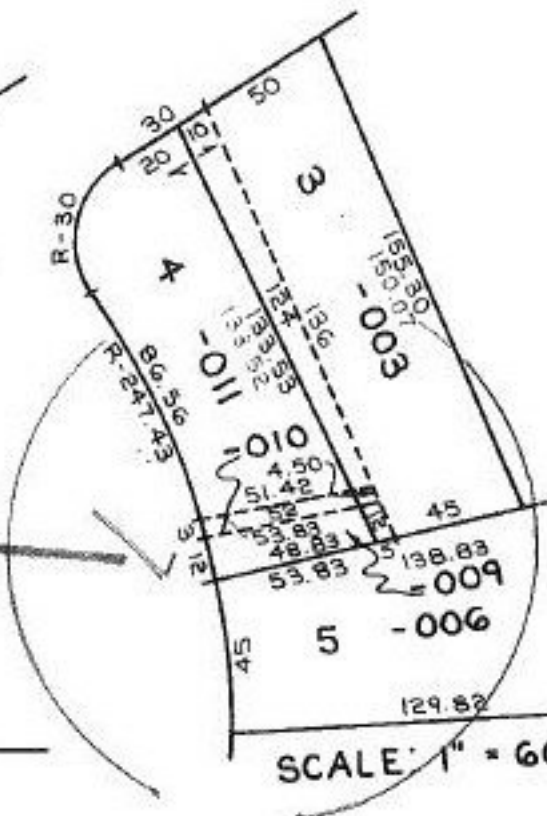

SCALE: 1" = 60'

DEED CHECK

R-15	114.23	
40	139 - 001	55
	129.07	
45	140 - 002	45
	128.94	
	141 - 003	
	128.81	
142	(III)	128.81
	143 - 005	
	128.55	
45	144 - 006	45
	128.42	

4/29/92  
19778-A

APPROVED LORAIN CO. MAP DEPT.	
DATE 3-11-92	
PAGE 2-02-027 CAROLYN BY FRANCIS	
VOID AFTER	19778-A