

447.24

02-02-001-104-071 0.10 A


-065 0.10 A

-062 0.14 A

0.34 A

Pl. - 038

Pl. B. 26 A.

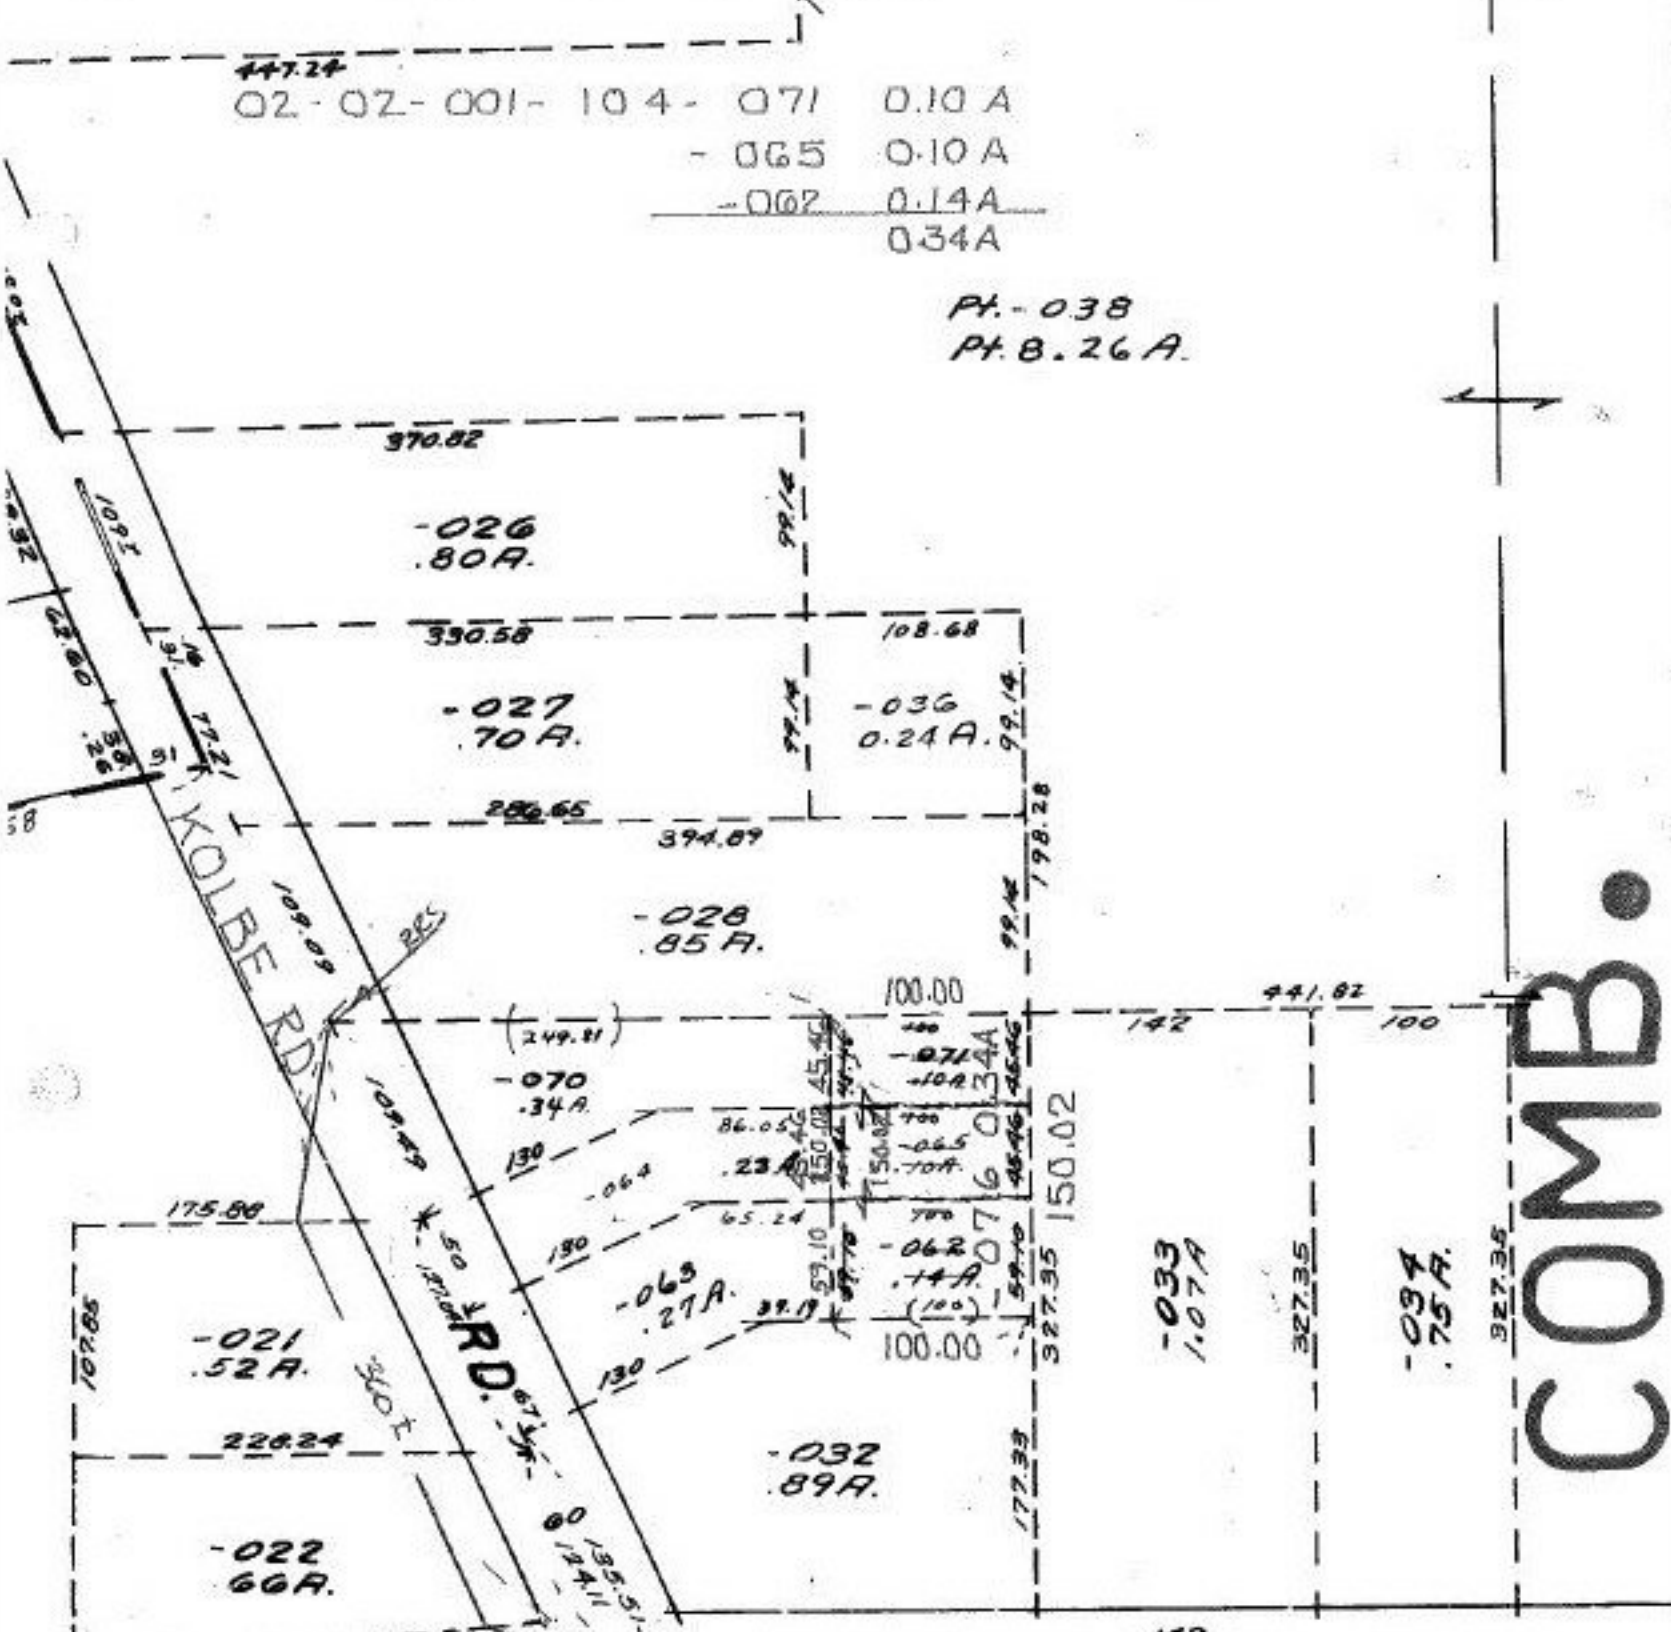

COMB.

-021-A

COOPER FOSTER PARK RD. 254 SH 4/29/92 19779 A

APPROVED
LORAIN CO.
MAP DEPT.

DATE 2-25-92

PAGE 2-02-001-A
CAR BLYN

BY FRANCIS

VOID AFTER # 19779A