

6.00 A.  
\* 9167.76 FROM M.B. F4 + E'S OF PYLE SOUTH AMHERST RD  
+ RUSSIA RD.

167.76  
17.29

1331.22

700.00

-052  
4.02A.

250.00


700.00

18.47A.  
- 4.02A.  
14.45A.

# 11751  
-053  
-023  
+8.47-A.  
14.45A.

36 250.00 400.02

RUSSIA RD

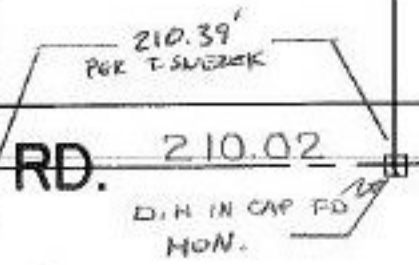

09-00-013-102- PRIOR INST: O.R. 448/589  
SURVEYED BY: THOMAS M. SIEZEK REG. SURVEYOR  
C=1: INF.

7/9/92  
19781

APPROVED  
LORAIN CO.  
MAP DEPT.  
DATE 2-20-92  
PAGE 9-00-013-B  
CAROLYN  
BY FRANCIS  
VOID AFTER # 19781