


.75A -020
10A
 .65A

 .72A -019
.09A
 .63A

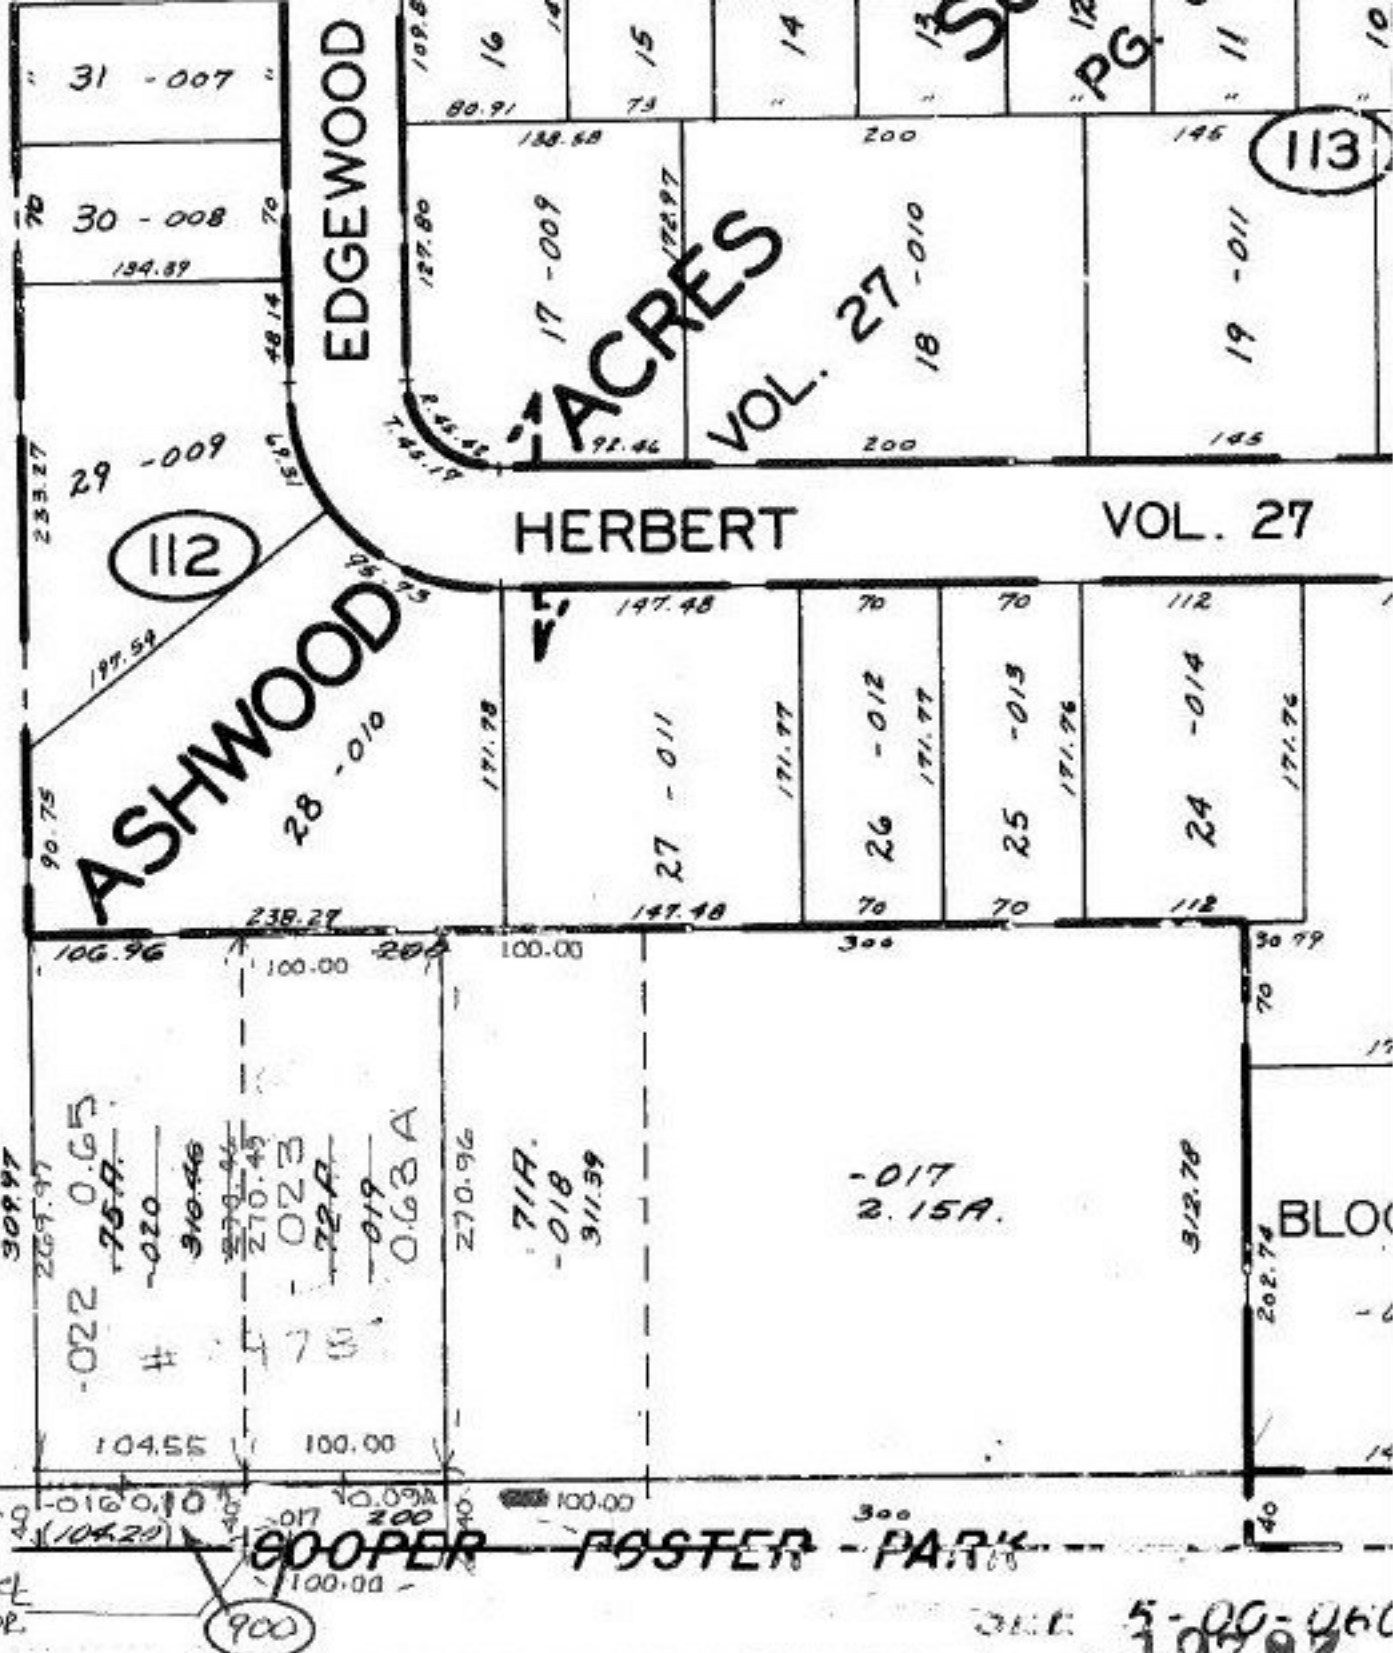

02-02-005-112 02-02-005-900- PRIOR INST: O.R.432/642
 SURVEYED BY: N.R. HURA REG. SURVEYOR
 C-1: 49,656 C-1: INF

SH 4/29/92

APPROVED
 LORAIN CO.
 MAP DEPT.

DATE 2-25-92

BLACK
 CAROLYN
 FRANCK

2-02005 A
 19787
 100

TRACT 2 W. PT. LOT 5

SCALE 1" = 100'

5-00-060
 19787