


14.14A  
0.37A  
13.77A

SEE 3-00-007-A

2140.79

-044  
-029  
-023  
13.77A

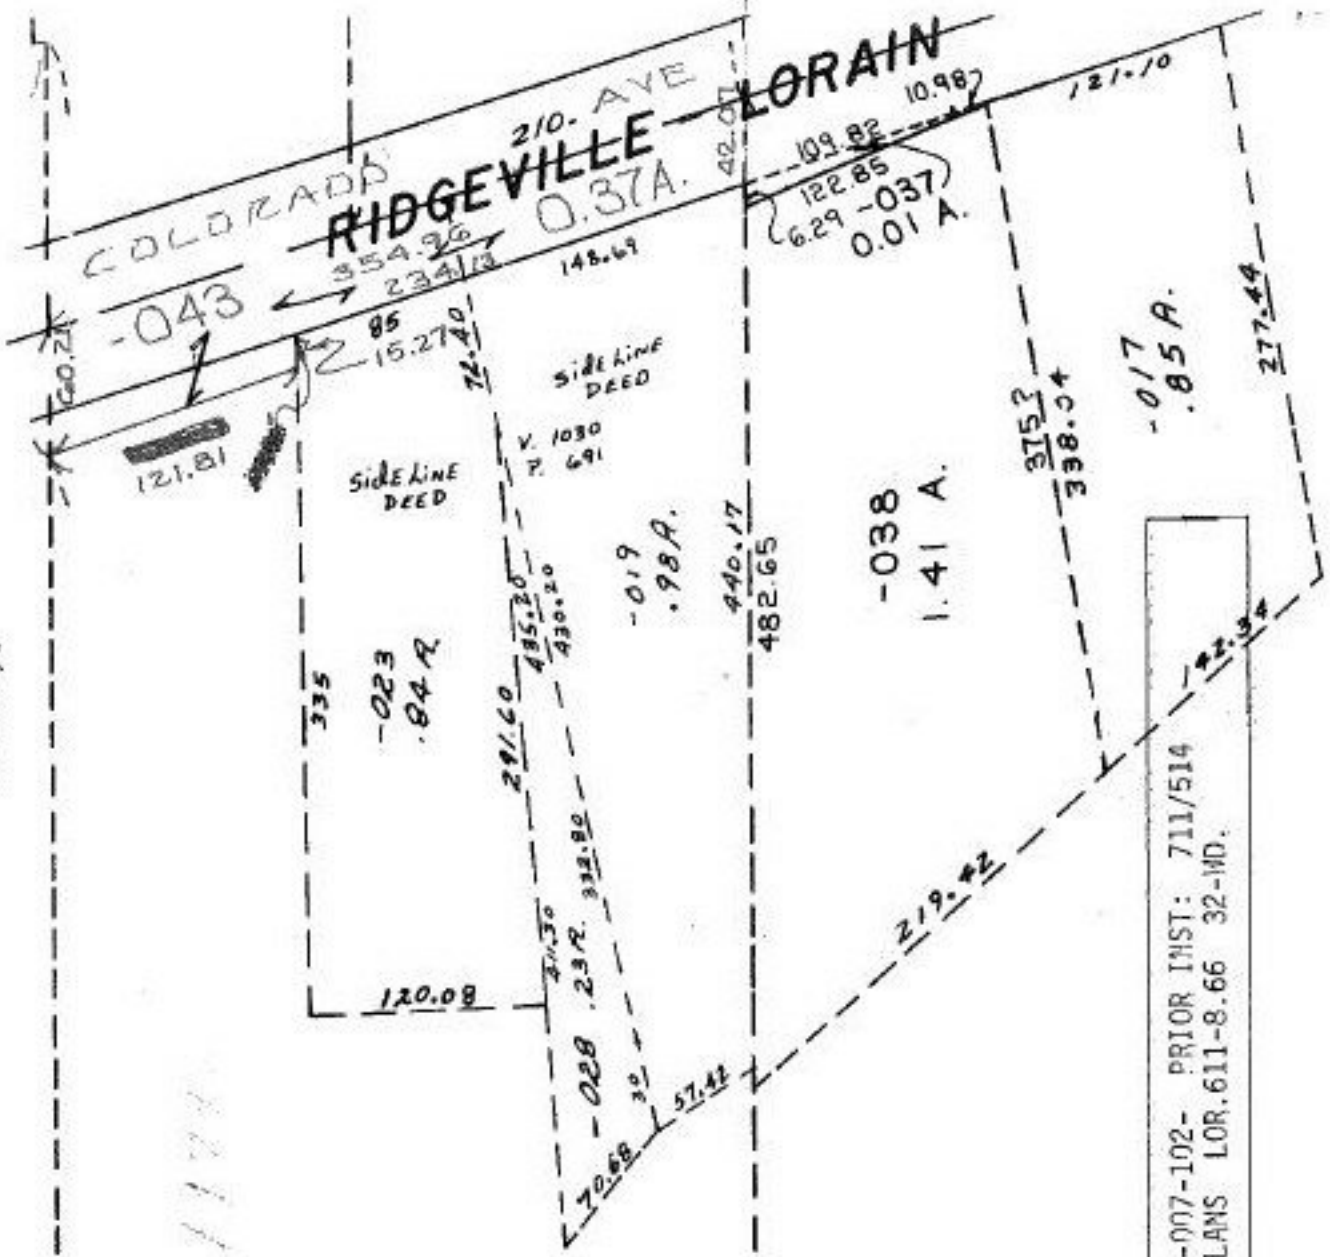

4/29/92  
19798

|                    |       |
|--------------------|-------|
| APPROVED           |       |
| LORAIN CO.         |       |
| MAP DEPT.          |       |
| DATE 7-28-92       |       |
| PAGE 3-00-007-A    |       |
| BY CAROLYN FRANCIS |       |
| VOID AFTER #       | 19798 |

B