

**DEED
CHECK**

- 109
~~72.44A.~~
79.44 A


SM 5/26/94

19800 A

APPROVED LORAIN CO. MAP DEPT.	DATE 3-23-94	PAGE 7-00-038C	BY <i>F. Spilant</i>	VOID AFTER 19800-A
-------------------------------------	--------------	----------------	----------------------	--------------------

7-00-038C

**NO CHANGES
OF TAX MAP**
LEGAL DESCRIPTION NEEDS
To Be Updated.

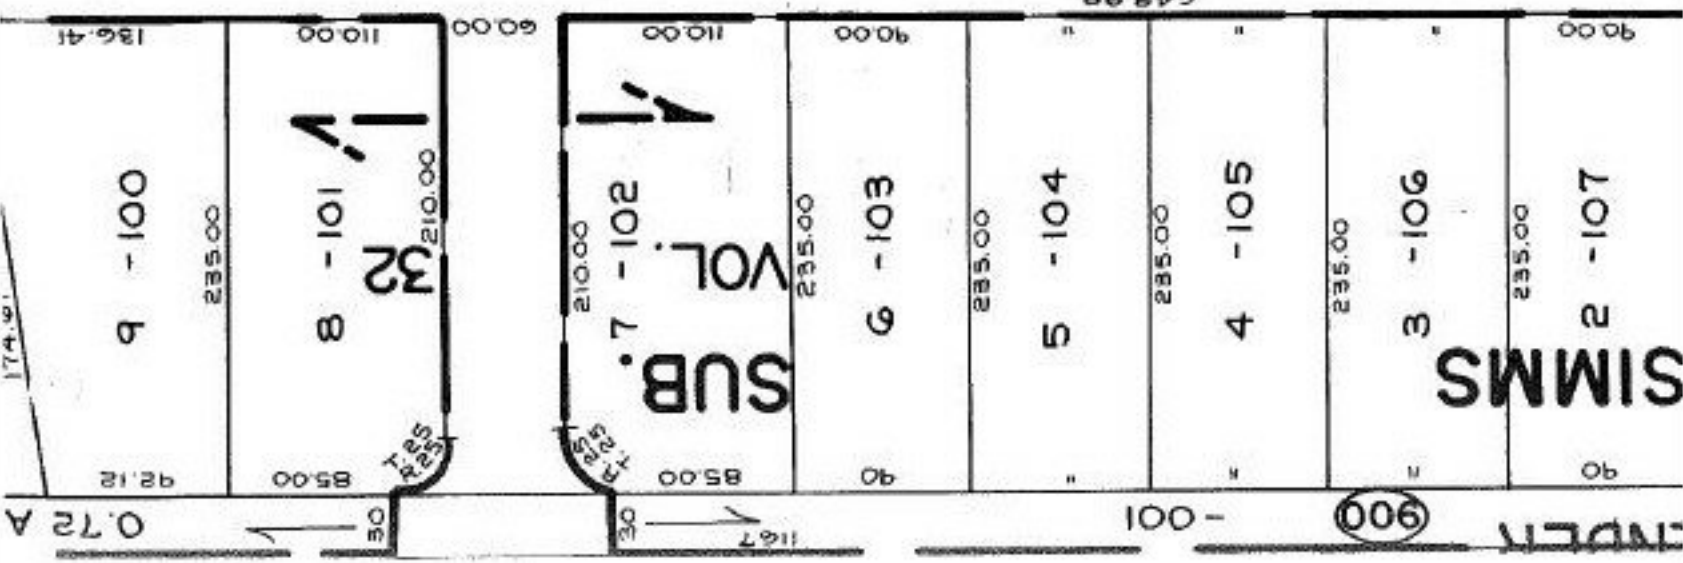

9 - 100

8 - 101

7 - 102

6 - 103

5 - 104

4 - 105

3 - 106

2 - 107

SIMMS

INDLN