


40.51 A.  
1.04 A  
 39.47 A.

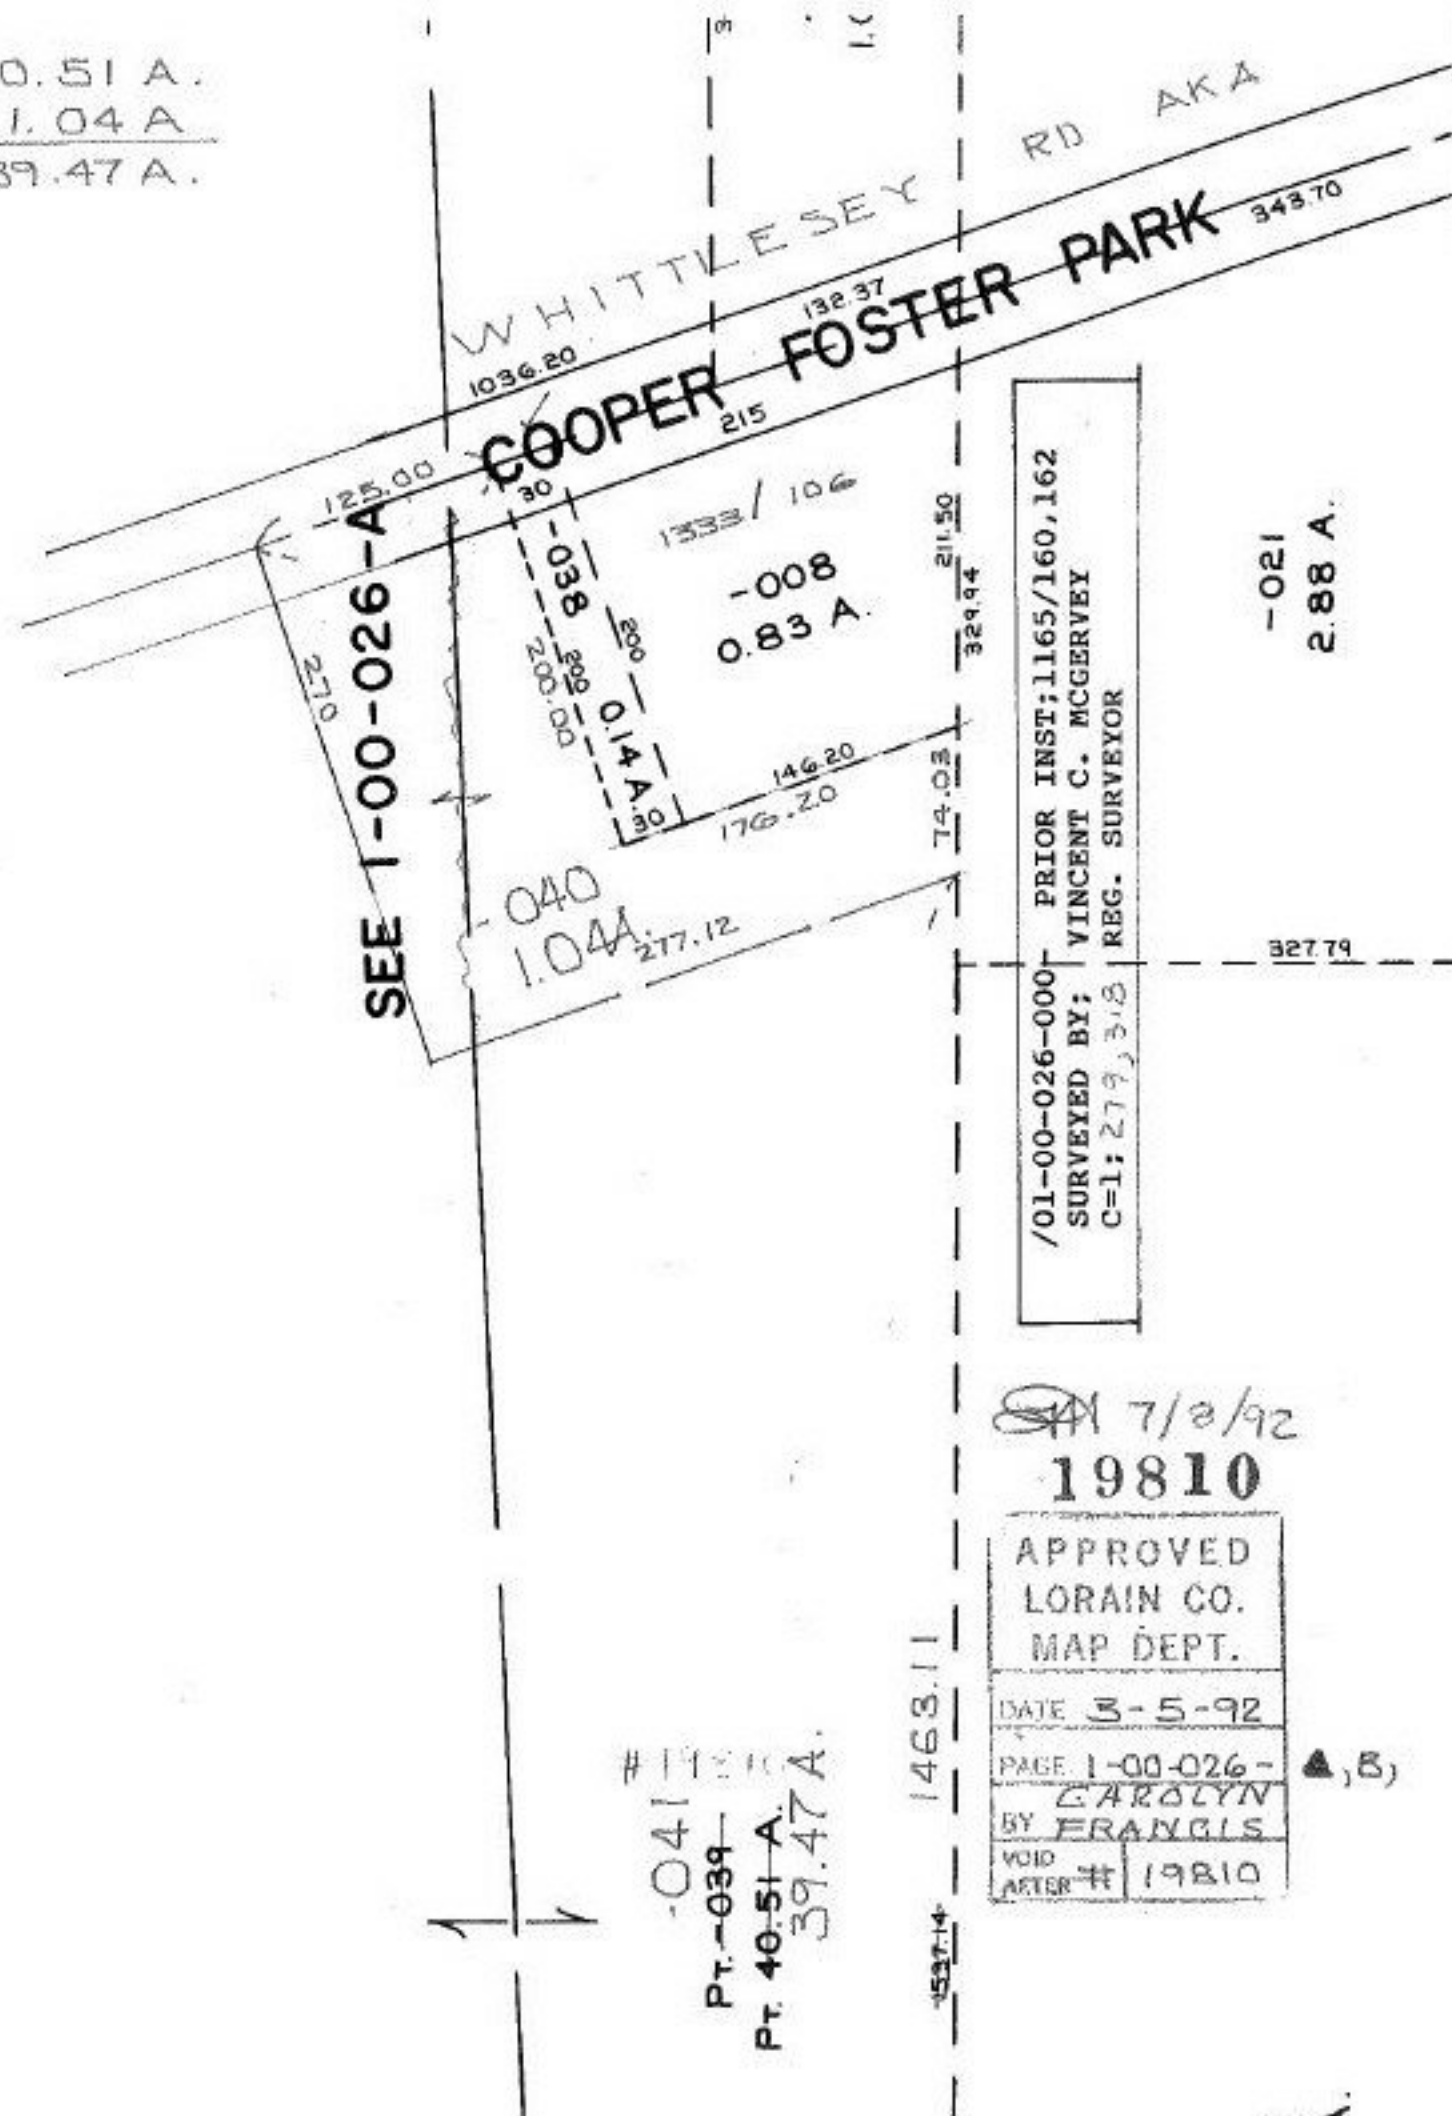

SEE 1-00-026-A

-040  
 1.04A

-008  
 0.83 A.

# 1-041  
 Pt. -039  
 Pt. 40.51 A.  
 39.47 A.

/01-00-026-000- PRIOR INST; 1165/160,162  
 SURVEYED BY; VINCENT C. MCGERVEY  
 C=1; 279, 318 REG. SURVEYOR

-021  
 2.88 A.

SA 7/2/92  
 19810

APPROVED  
 LORAIN CO.  
 MAP DEPT.  
 DATE 3-5-92  
 PAGE 1-00-026-  
 BY CAROLYN  
 BY FRANCIS  
 VOID AFTER # 19810

1463.11

▲, B)

A.