


S

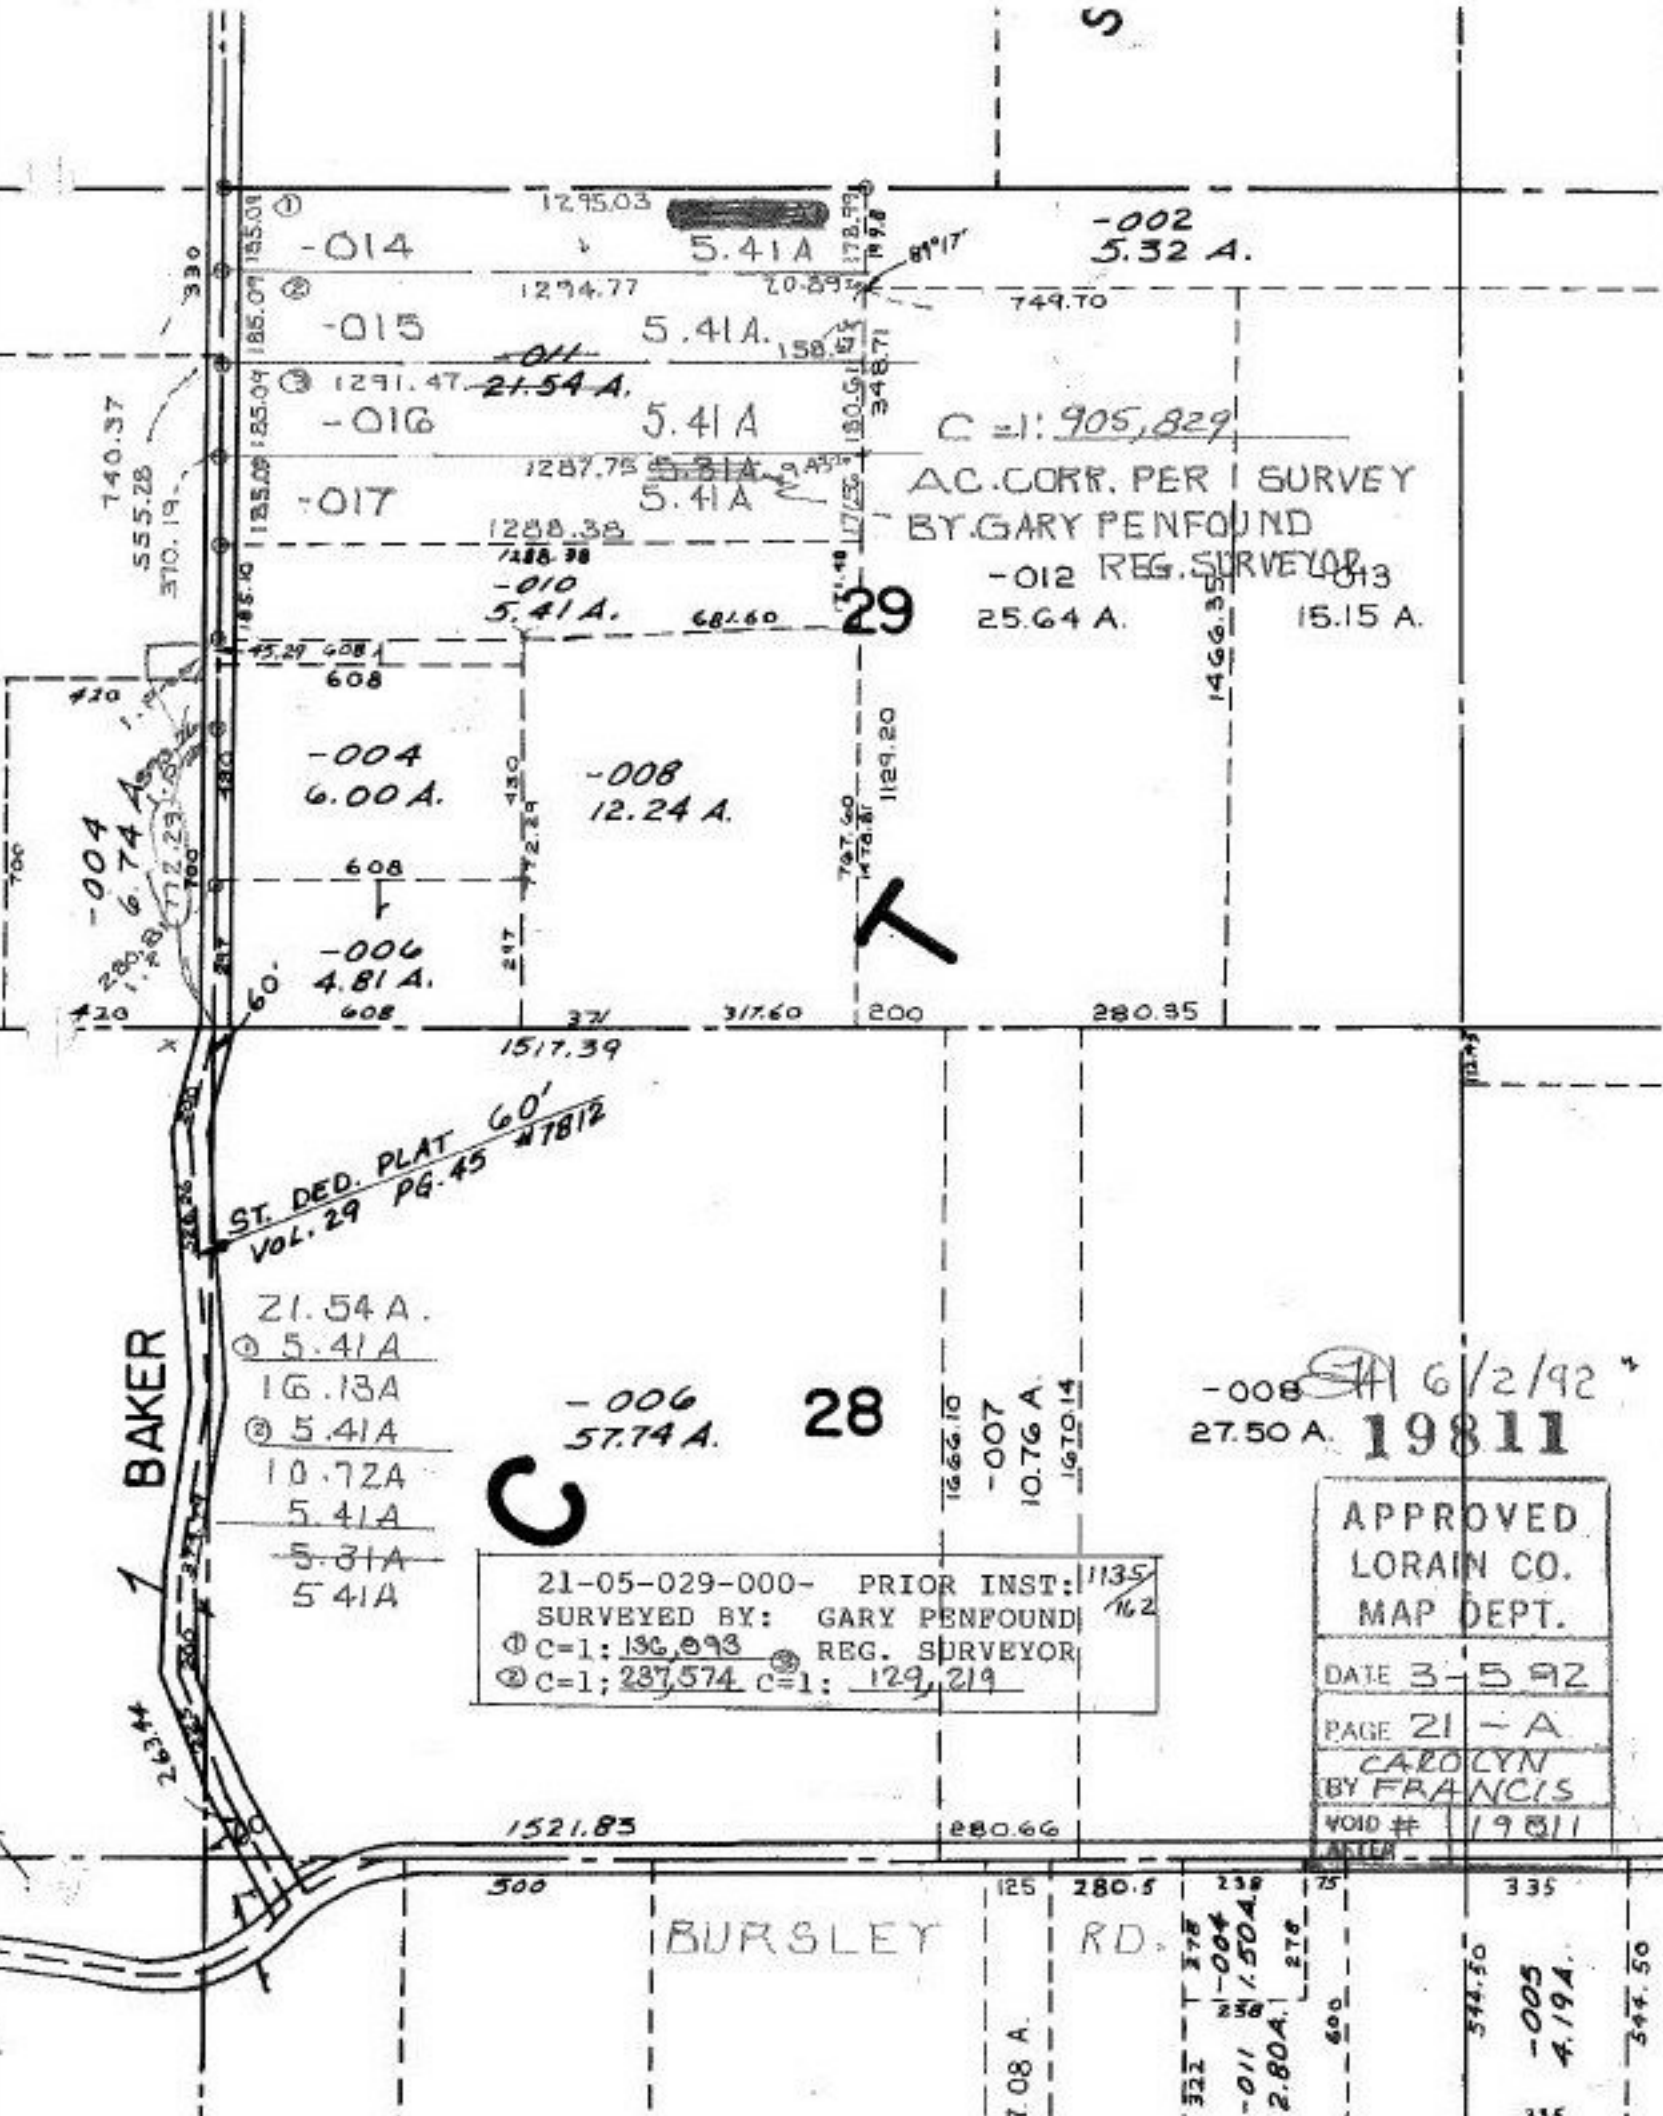

ST. DED. PLAT 60'
VOL. 29 PG. 45 #7812

21.54 A.
① 5.41 A
16.13 A
② 5.41 A
10.72 A
5.41 A
5.31 A
5.41 A

C

-006 57.74 A. **28**

21-05-029-000- PRIOR INST: 1135
SURVEYED BY: GARY PENFOUND 162
① C=1: 136,093 REG. SURVEYOR
② C=1: 237,574 C=1: 129,219

-008 SA 6/2/92
27.50 A. **19811**

APPROVED
LORAIN CO.
MAP DEPT.
DATE 3-5-92
PAGE 21 - A
CAROLYN
BY FRANCIS
VOID # 19811
AFTER

BURSLEY

RD.

7.08 A.
322 278
-011 1.504
2.80 A. 278
600
335
544.50
-005 4.19 A.
335
344.50