


2.12
+0.57

2.71

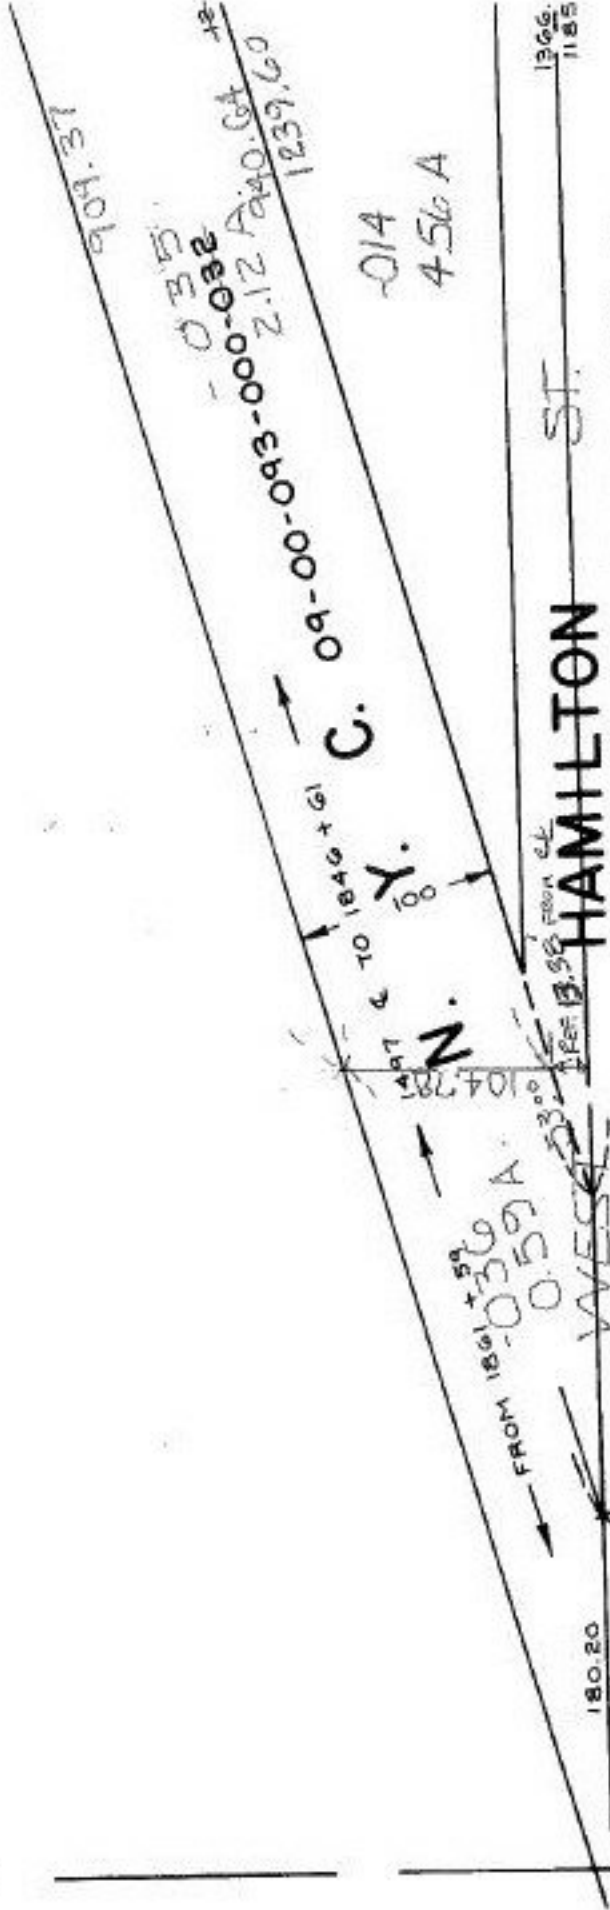

SEE 9-00-103-B

09-00-093-000- PRIORITY INST: 1399/437
 SURVEYED BY: LAUNDON, SIMON, CAHL & ASSOC.
 C=1:310,394

SPN 7/9/92

19816

APPROVED
LORAIN CO.
MAP DEPT.
DATE 3-11-92
PAGE 9-00-093-B
CAROLYN
BY FRANGIS
VOID # 19816
ASTER

