


SEE 13-E

BAIRD RD

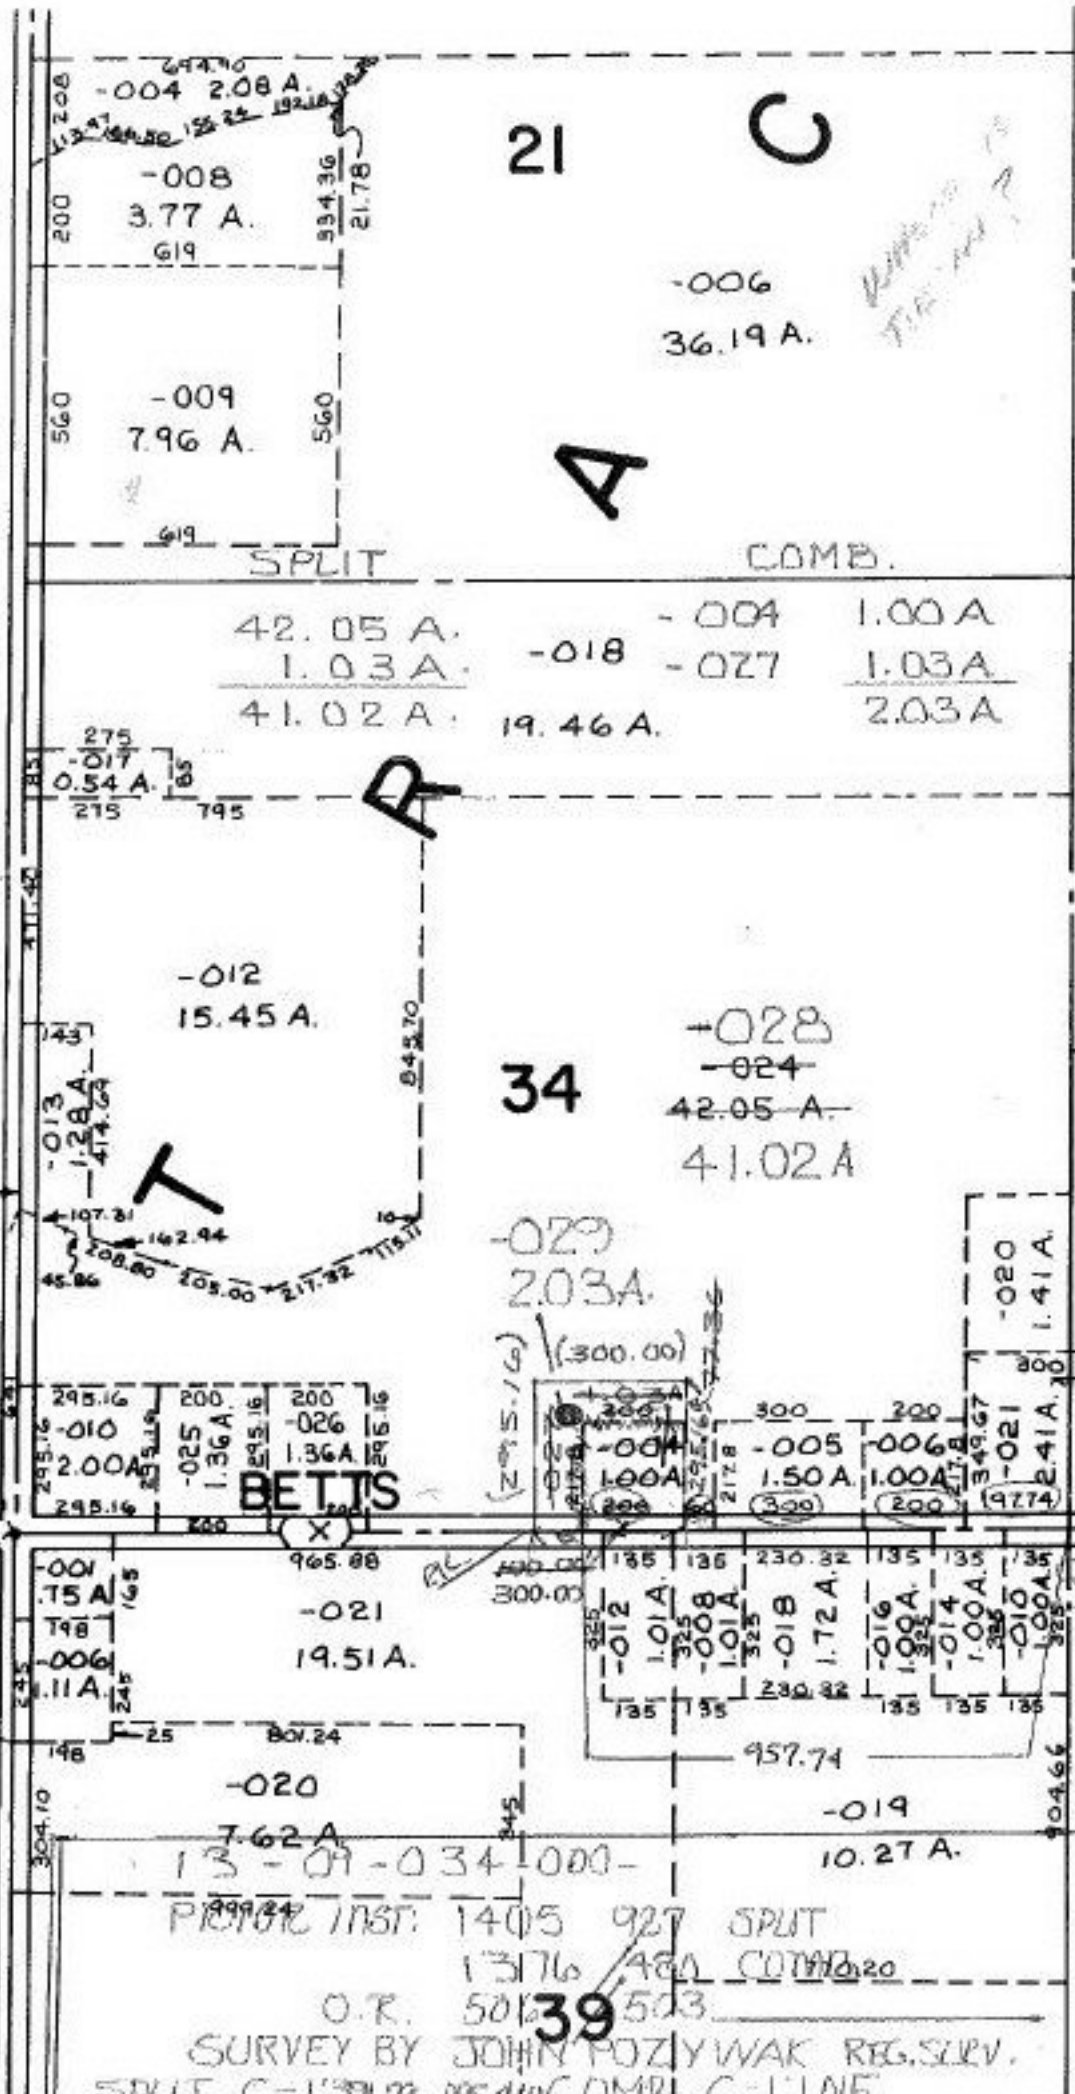

944.13

352

904.65

SPLIT COMB.

-008 7.88 A.

-00
39.6

APR 1 A 1982
19826

APPROVED
LORAIN CO.
MAP DEPT.

DATE 3-19-92

PAGE 13-F

BY CAROLYN
FRANCIS

WKS
19826

PROMPT INST. 1405 927 SPLIT
13176/480 COMB. 20
O.R. 501 39 503
SURVEY BY JOHN POZYWAK REG. SURV.
SPLIT C = 1377 78 085 410 C DMRL C = LINE