


SEE 9-00-013

1025' to E. Russia Rd
MAN BOX

SOUTH AMHERST

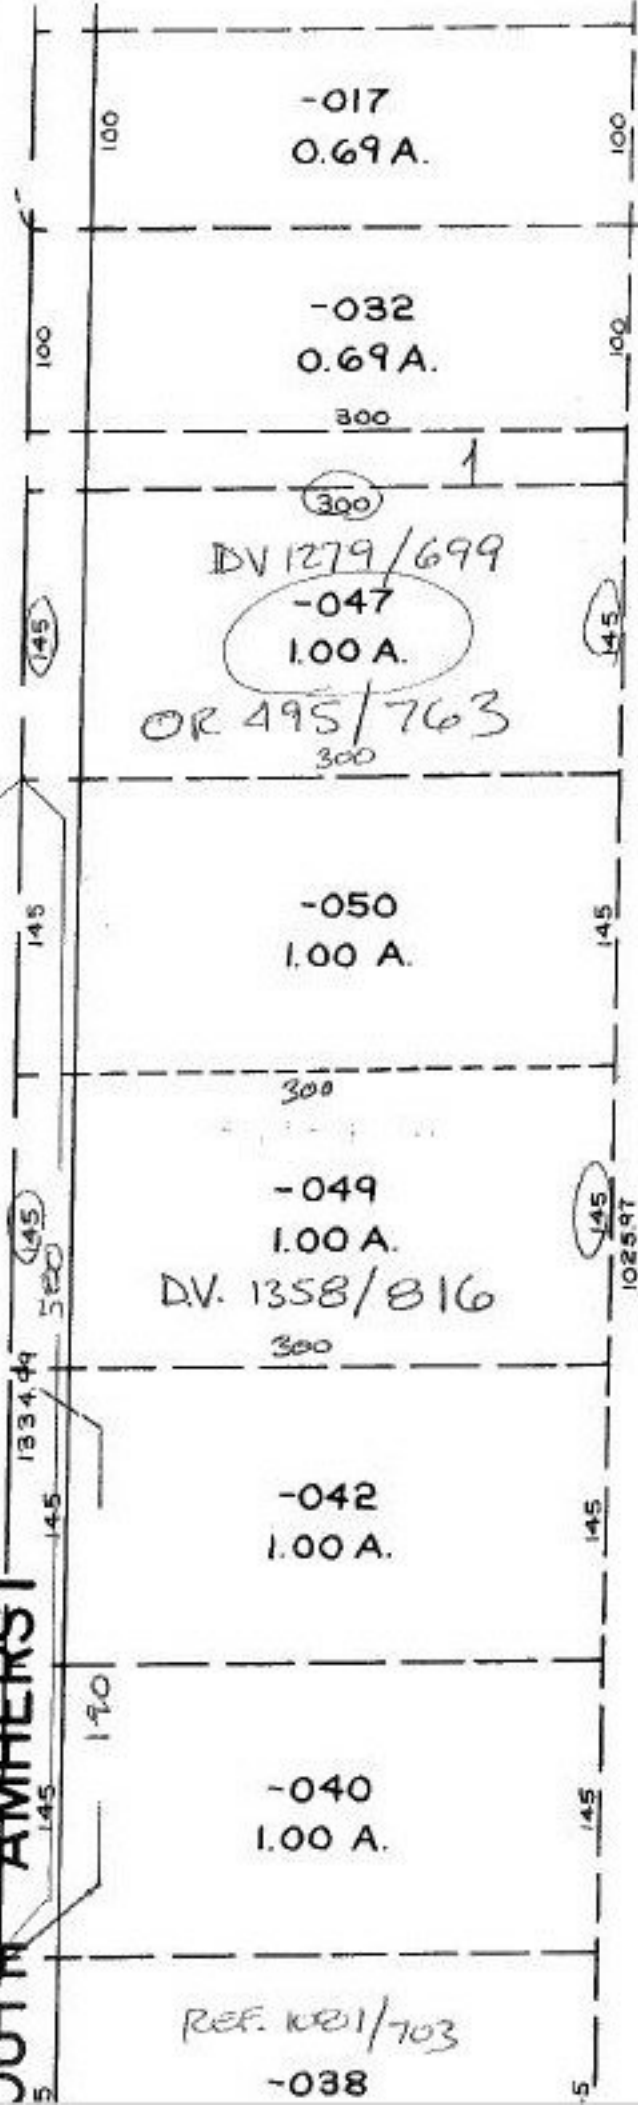

336.23

131

COPIES OF DEEDS SHOW
LOCATIONS OF -047 & -049
TO BE CORRECT. SEE PARCELS
FOR REFERENCE DEEDS.

MAP & REGISTER OK
NAME CORRECTION ON
DUPLICATE NECESSARY

-019
7.99 A.

-021
4.00 A.

7/19/92
#19841-A

DEED CHECK

APPROVED
LODMAN CO.
MORRISVILLE
DATE 4/2/92
PAGE 9-00-013-B
BY T. McNamee
19841-A

REF. 1001/703

-038