


Lake

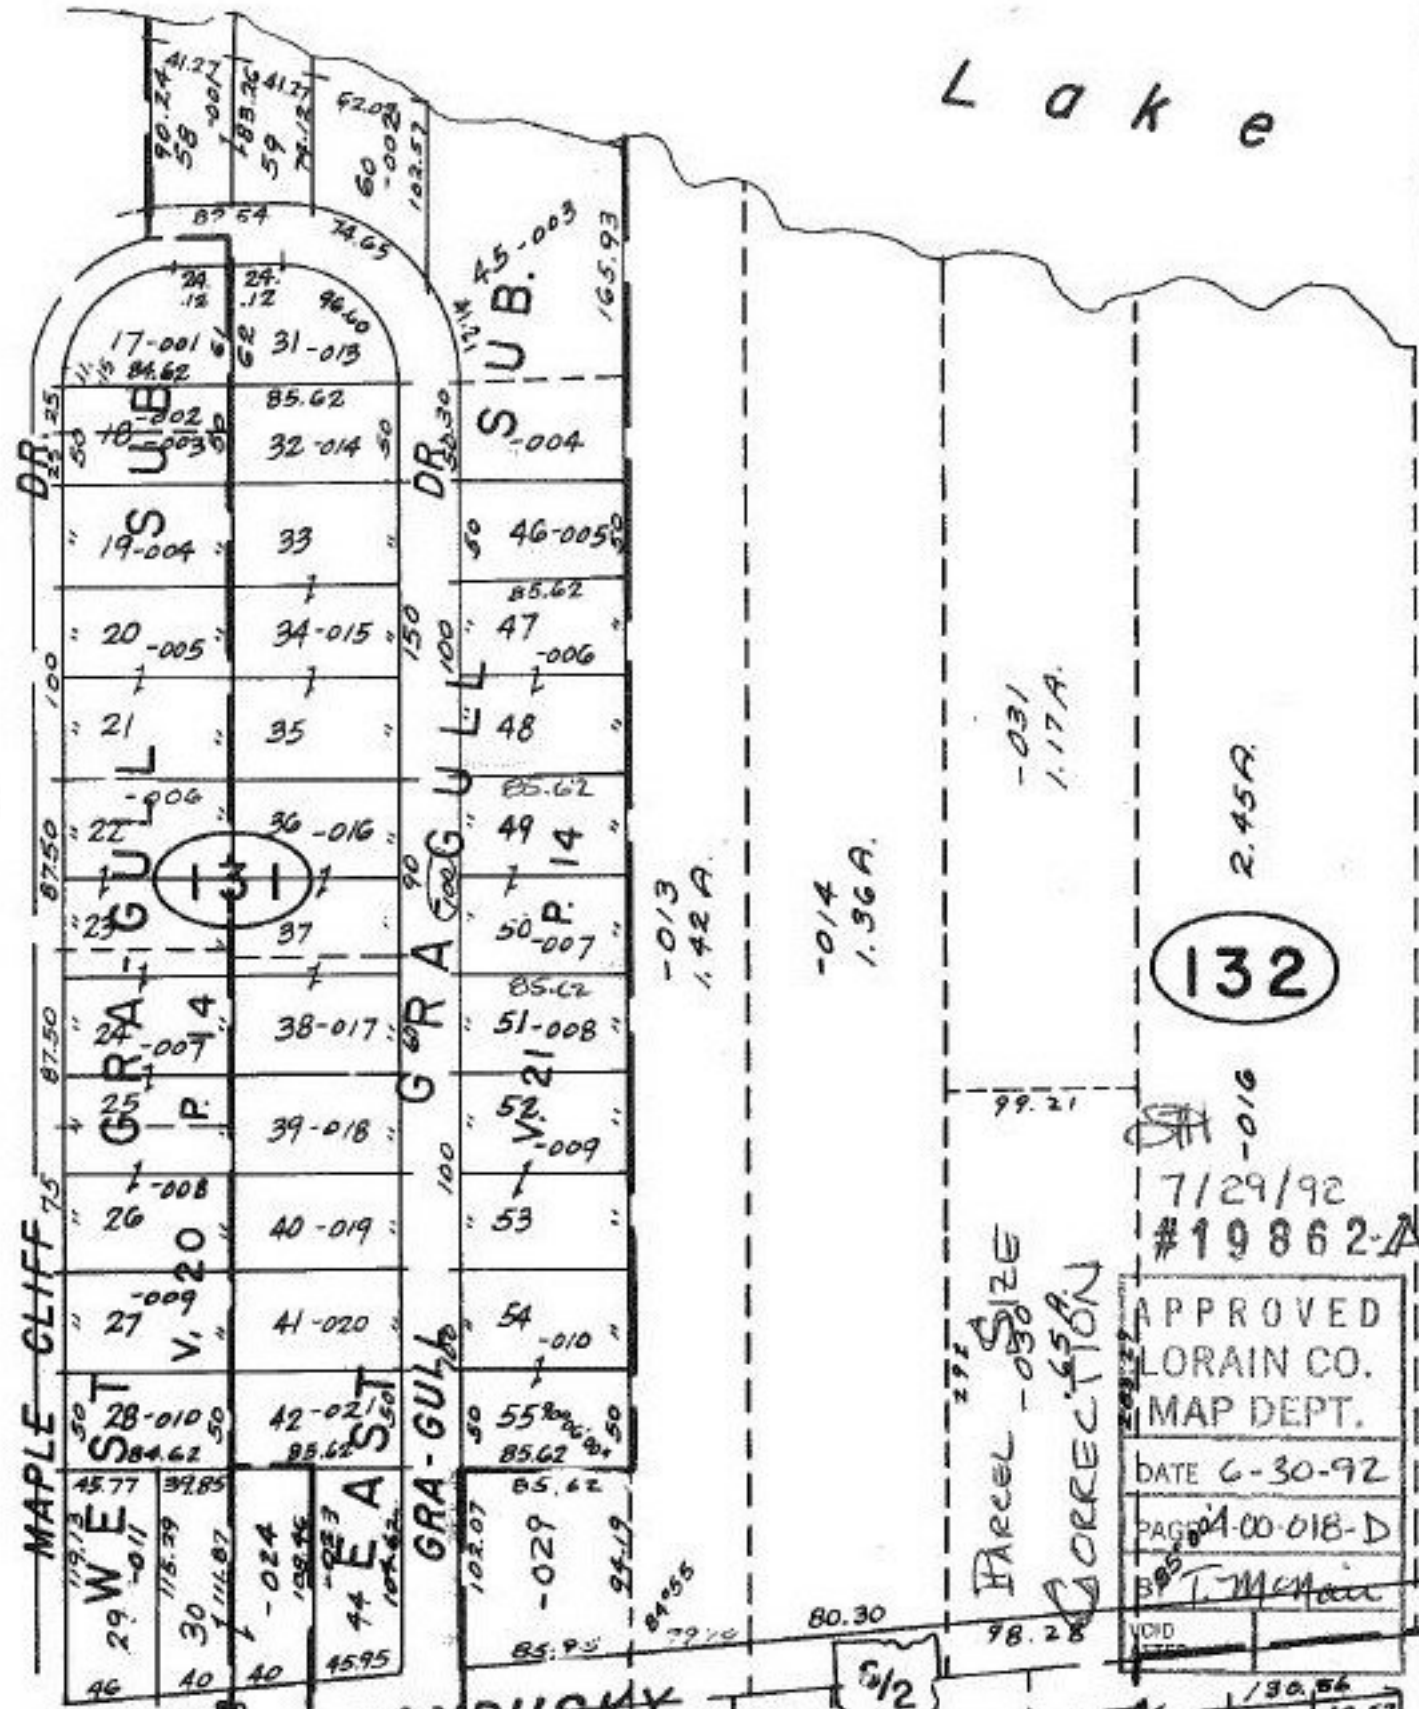

132

7/29/92
 #19862-A

APPROVED
 LORAIN CO.
 MAP DEPT.

DATE 6-30-92

PAGE 4-00-018-D

BY T. McH...

VOID

Parcel Size
 Correction

CLEVELAND SANDUSKY

135.79
 35.29
 16-003
 138.93

130.56
 49.52
 140
 144.07
 148.15
 152.22
 49.33
 49.33
 49.34
 130
 5