

# TURNPIKE

PT.-052  
PT. 16.37 A.

2.31 A  
2.57 A  
~~4.88 A~~  
5.00 A

1017.92  
- III  
2.80 A.

1009.88

095

2.31 A

1010.43

- 112

4.88 A  
5.00 A

096

2.57 A.

AC. CORR. PER SURVEY DONE BY C.T. BIGGS.

1014.57

7/15/92  
19864


C = 12 284,589

PRIOR INST. 1203 / 579

07-00-034-0000-095  
- 096  
- 104  
7.73 A.

# COMB.

|                 |
|-----------------|
| APPROVED        |
| CORAIN CO.      |
| MAP DEPT.       |
| JUNE 4-13-92    |
| PAGE 7-00-034-D |
| CAROLYN         |
| FRANCIS         |
| LOG # 19864     |

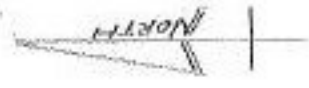

MADDOCK RD  
215 55  
103

1396  
33110

150.50

100

215

103

157.57

127

103