


N. Y. C. R. R.

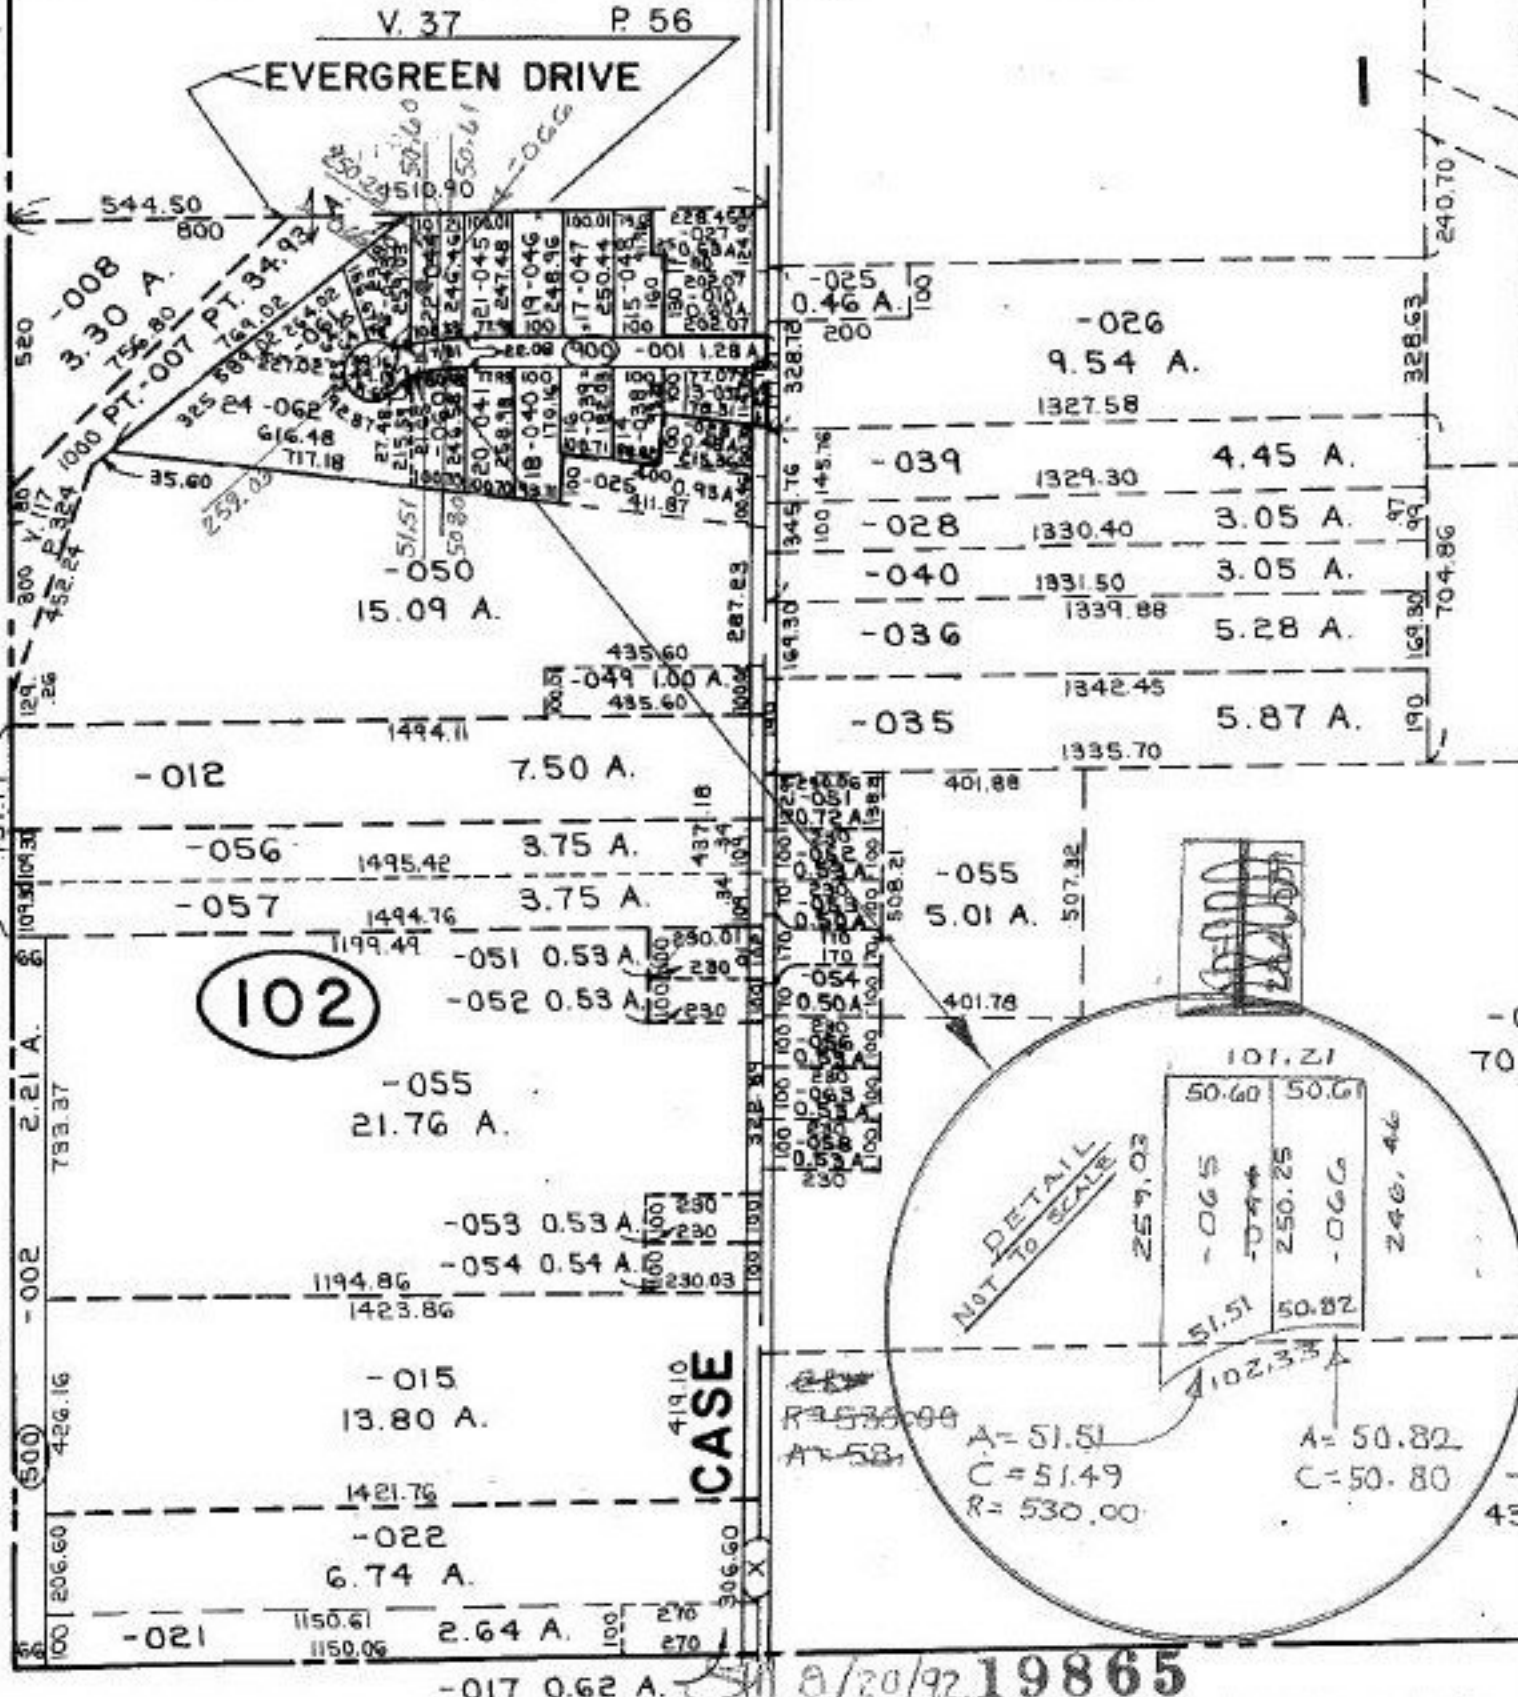

04-00-001-102- PRIOR INST:O.R.112/34 surveyed by; James A. RESAR REG. SURV. C=1:96,584

8/20/92 19865

APPROVED
LORAIN CO.
MAP DEPT.
DATE 4-13-92
PAGE 4-T
BY FRANCIS
VOID # 19865

SEE 7-A