


SEE 2-02-007-B

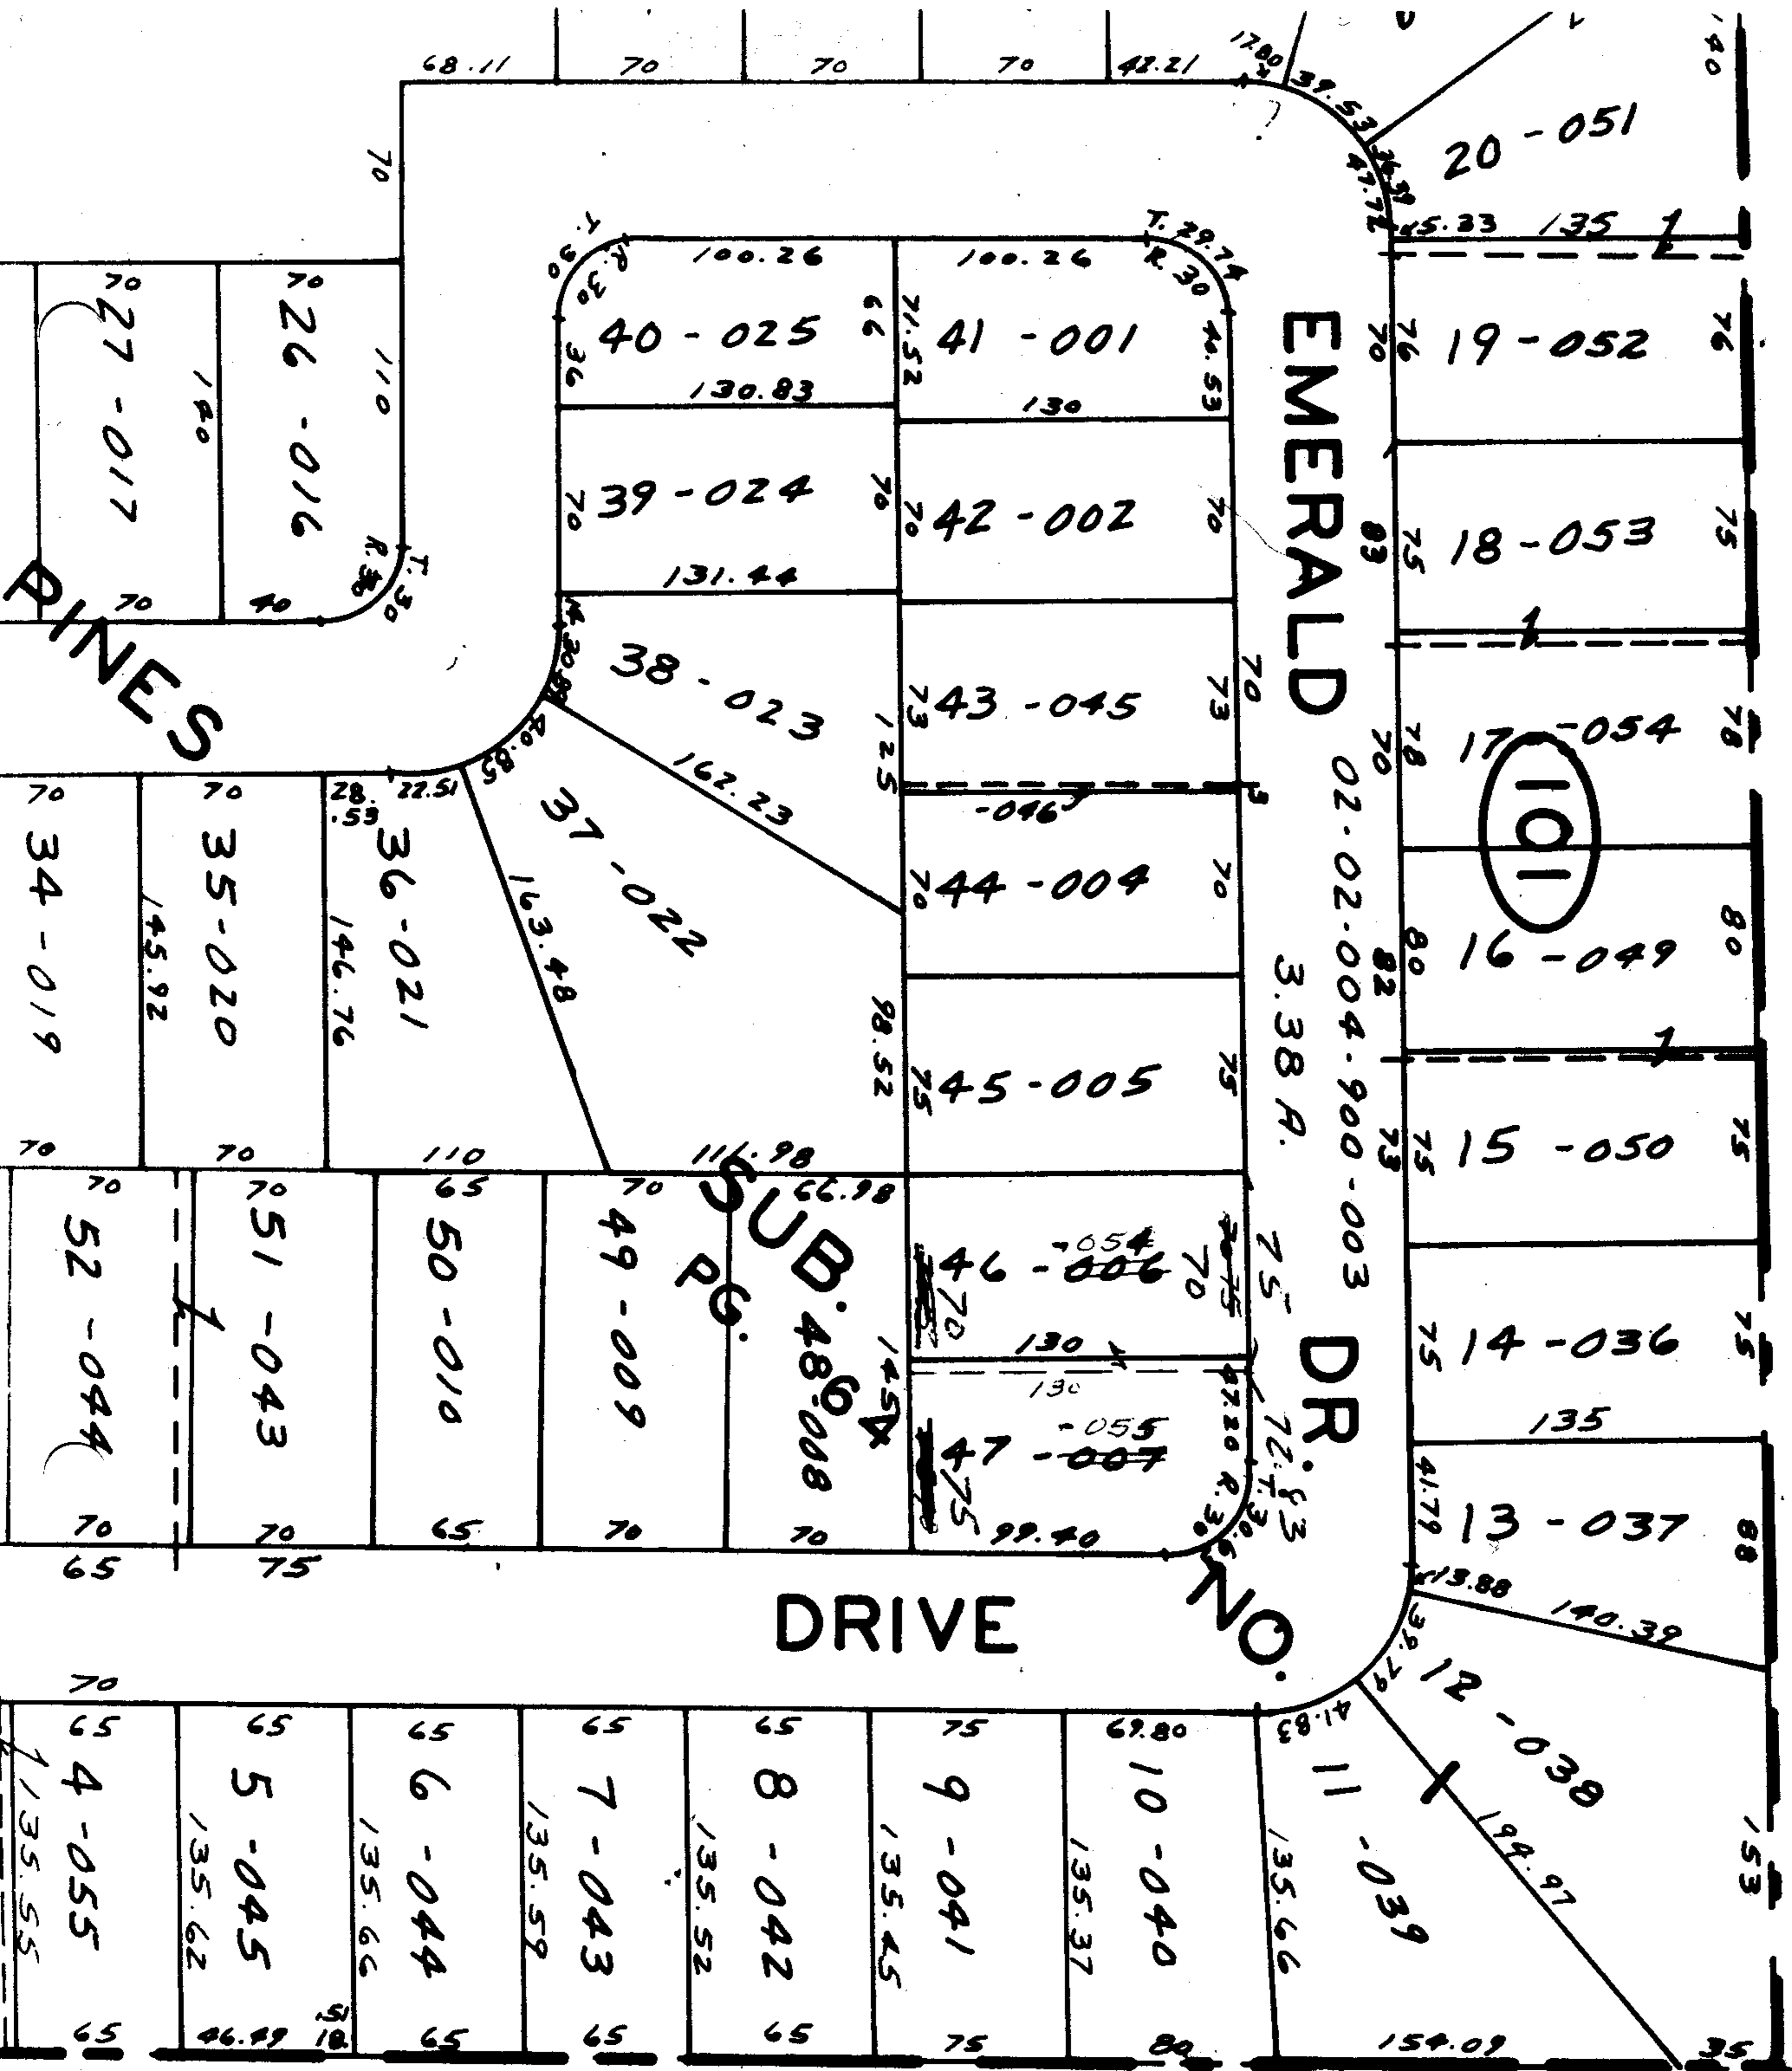

02-02-004-110

1987

Look At Transfer Sheet

APPROVED  
 LORAIN CO.  
 MAP DEPT.  
 DATE 7/30/68  
 BY [Signature]  
 2-02-004B  
 9/23/68  
 R.K.

[Signature]