


101

COLGATE

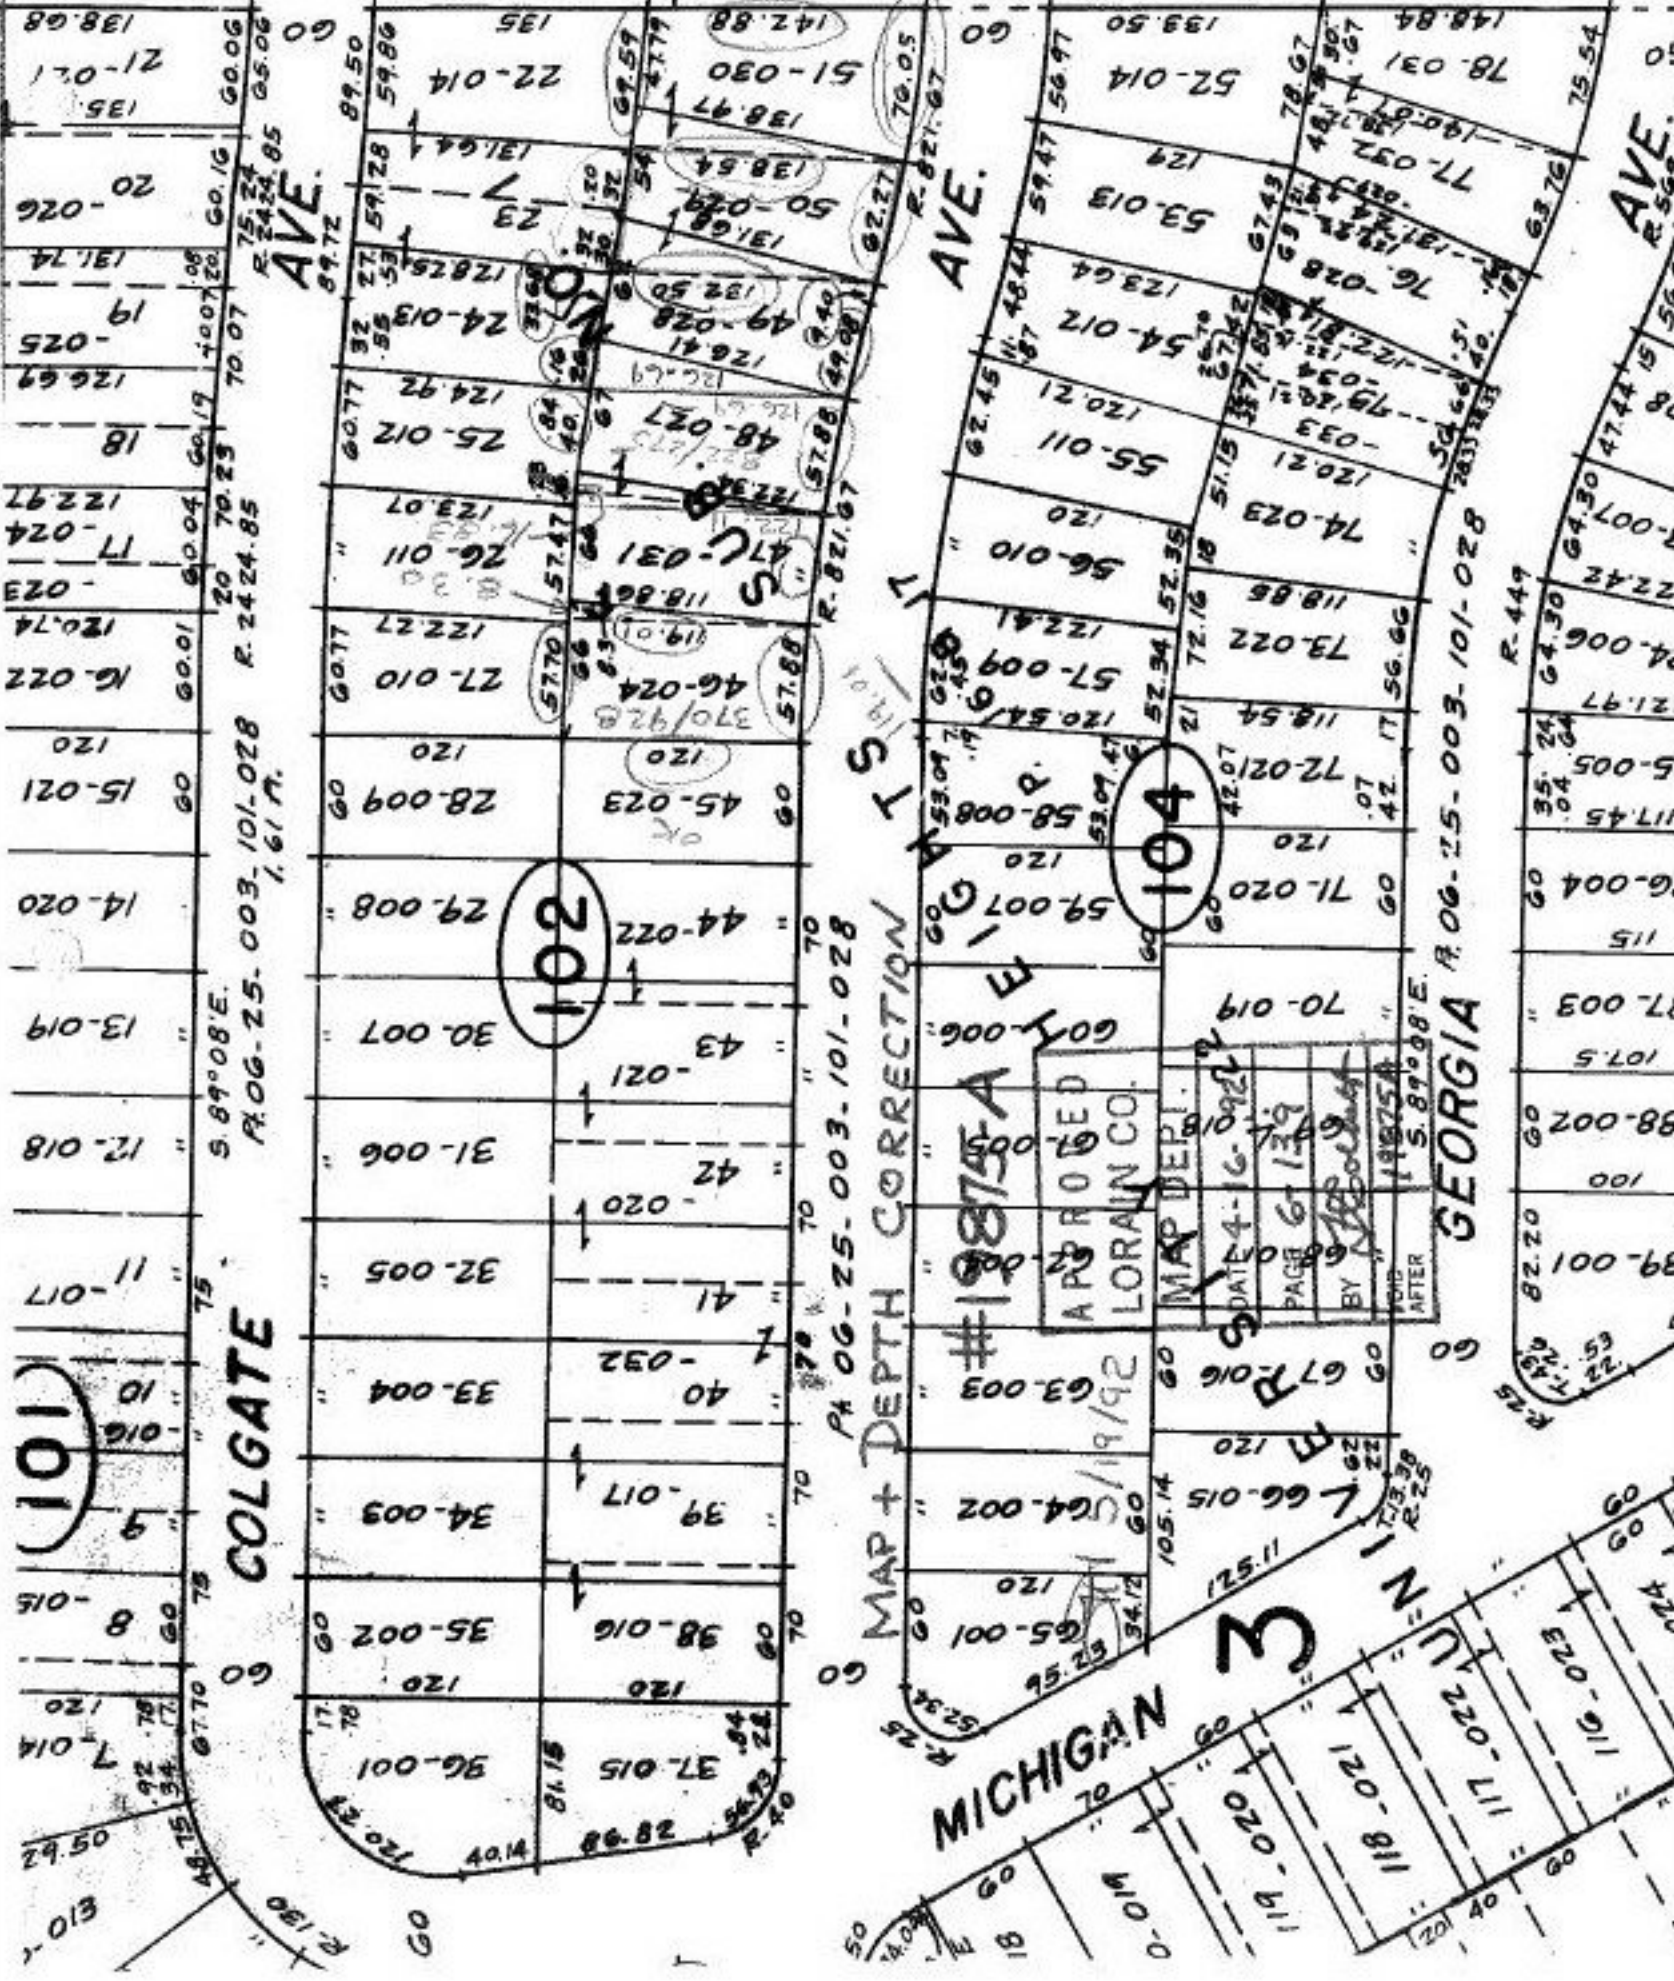

5.89° 08' E. 5.89' 08' E.  
 R. 06-25-003-101-028 1.61 P.  
 5.89° 08' E. 5.89' 08' E.  
 R. 06-25-003-101-028 1.61 P.  
 5.89° 08' E. 5.89' 08' E.  
 R. 06-25-003-101-028 1.61 P.

101  
 102  
 103  
 104

MAP + DEPTH CORRECTION  
 #19875-A  
 LORAIN CO.  
 MAP DEPT.  
 DATE 4-16-1992  
 PAGE 6  
 BY [signature]  
 TOWN OF [signature]  
 AFTER 11/27/54  
 S. 89° 08' E.

MICHIGAN AVE  
 3  
 117-022  
 118-021  
 119-020  
 120-019

5.89° 08' E. 5.89' 08' E.  
 R. 06-25-003-101-028 1.61 P.

6-139  
 1043/431  
 pt 10.62 A  
 801/735  
 5.0° 00' 30" W