

HORSESHOE

STABLE

TURTLE RUN

BLOCK -076

BLOCK X

105

DRIVE

BLOCK Y

106

BLOCK -047

15-00-078-105 PRIOR INST. O.R. 41/530 SURVEY BY K.S.A. RUN


C = LINE

QUARTER HORSE

RY

BLOCK B - B

15X-00-098-A

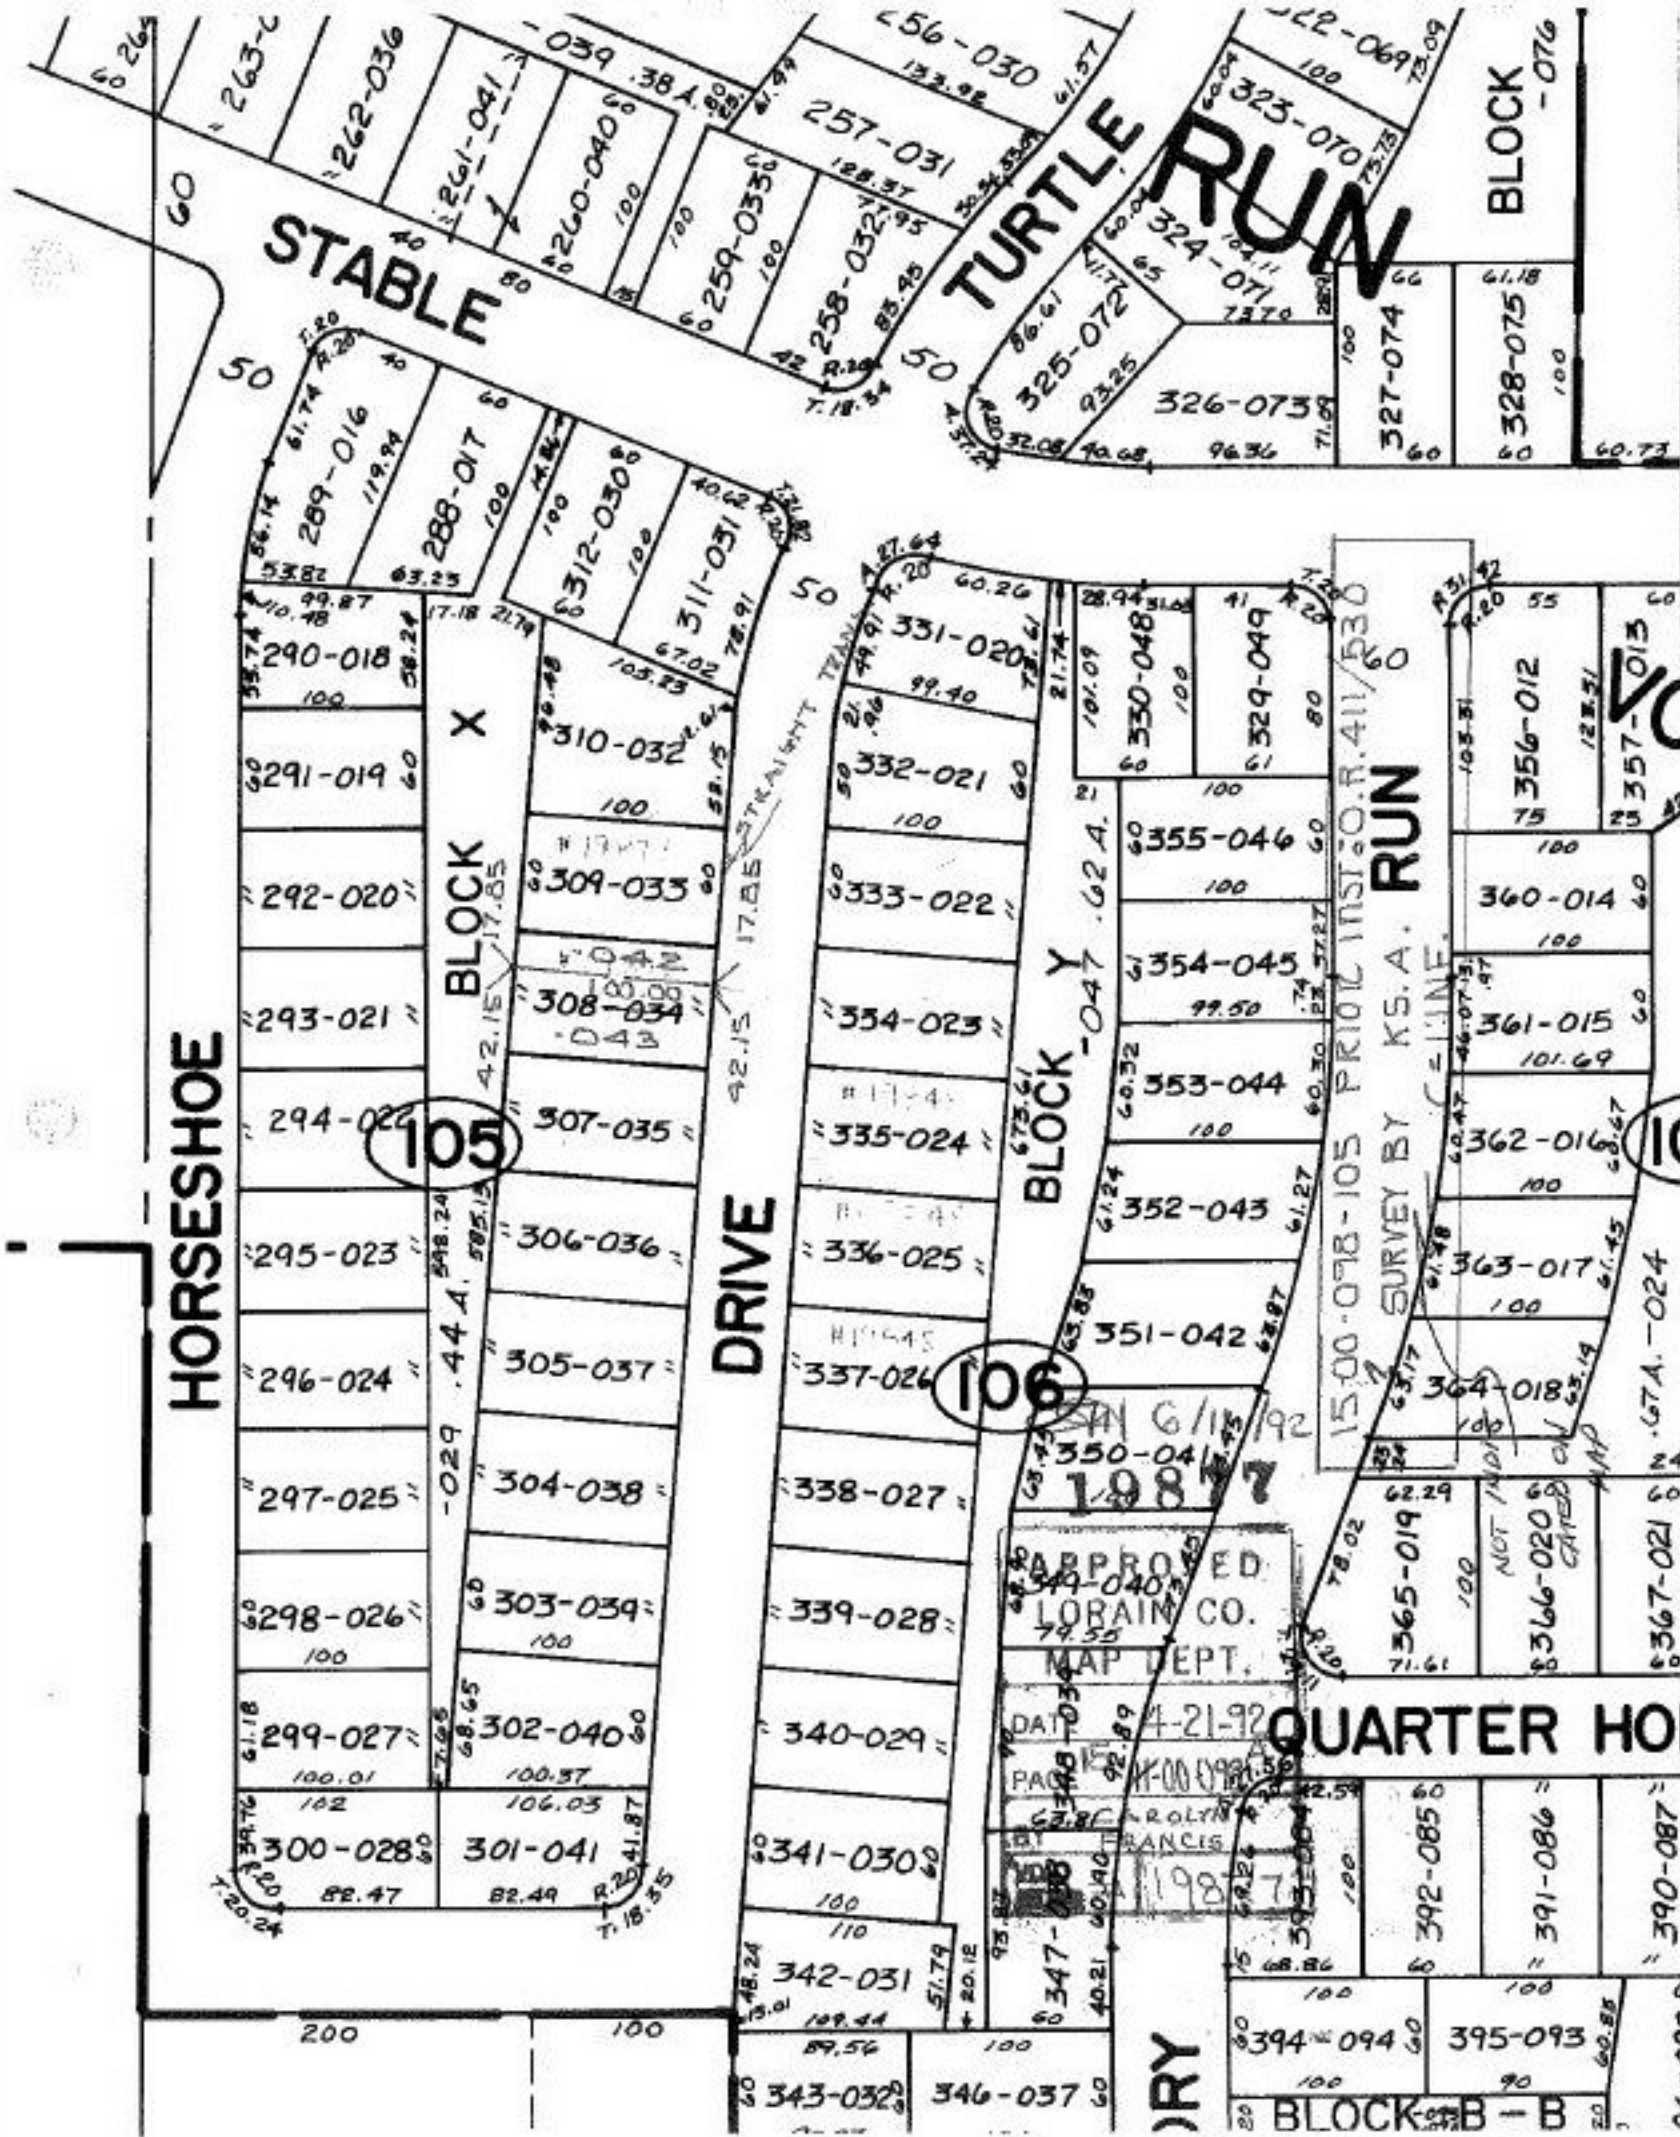

263-0
262-036
261-041
260-040
259-033
258-032
257-031
256-030

323-070
324-071
325-072
326-073
327-074
328-075

289-016
288-017
312-030
311-031
310-032
309-033
308-034
307-035

331-020
332-021
333-022
334-023
335-024
336-025
337-026
338-027
339-028
340-029
341-030
342-031
343-032
346-037

350-048
352-043
353-044
354-045
355-046
351-042
350-041

356-012
357-013
360-014
361-015
362-016
363-017
364-018
365-019
366-020
367-021
390-087

290-018
291-019
292-020
293-021
294-022
295-023
296-024
297-025
298-026
299-027
300-028
301-041
302-040
303-039
304-038
305-037
306-036

347-034
348-035
349-040
350-041
351-042
352-043
353-044
354-045
355-046
356-012
357-013
360-014
361-015
362-016
363-017
364-018
365-019
366-020
367-021

329-049
330-048
331-020
332-021
333-022
334-023
335-024
336-025
337-026
338-027
339-028
340-029
341-030
342-031
343-032
346-037

394-094
395-093
396-085
397-086
398-087

APPROVED
LOBAIN CO.
MAP DEPT.
DATE 4-21-92
BY CAROLYN FRANCIS

1987

10

10

