


-045-B

NORTH CENTER ST.

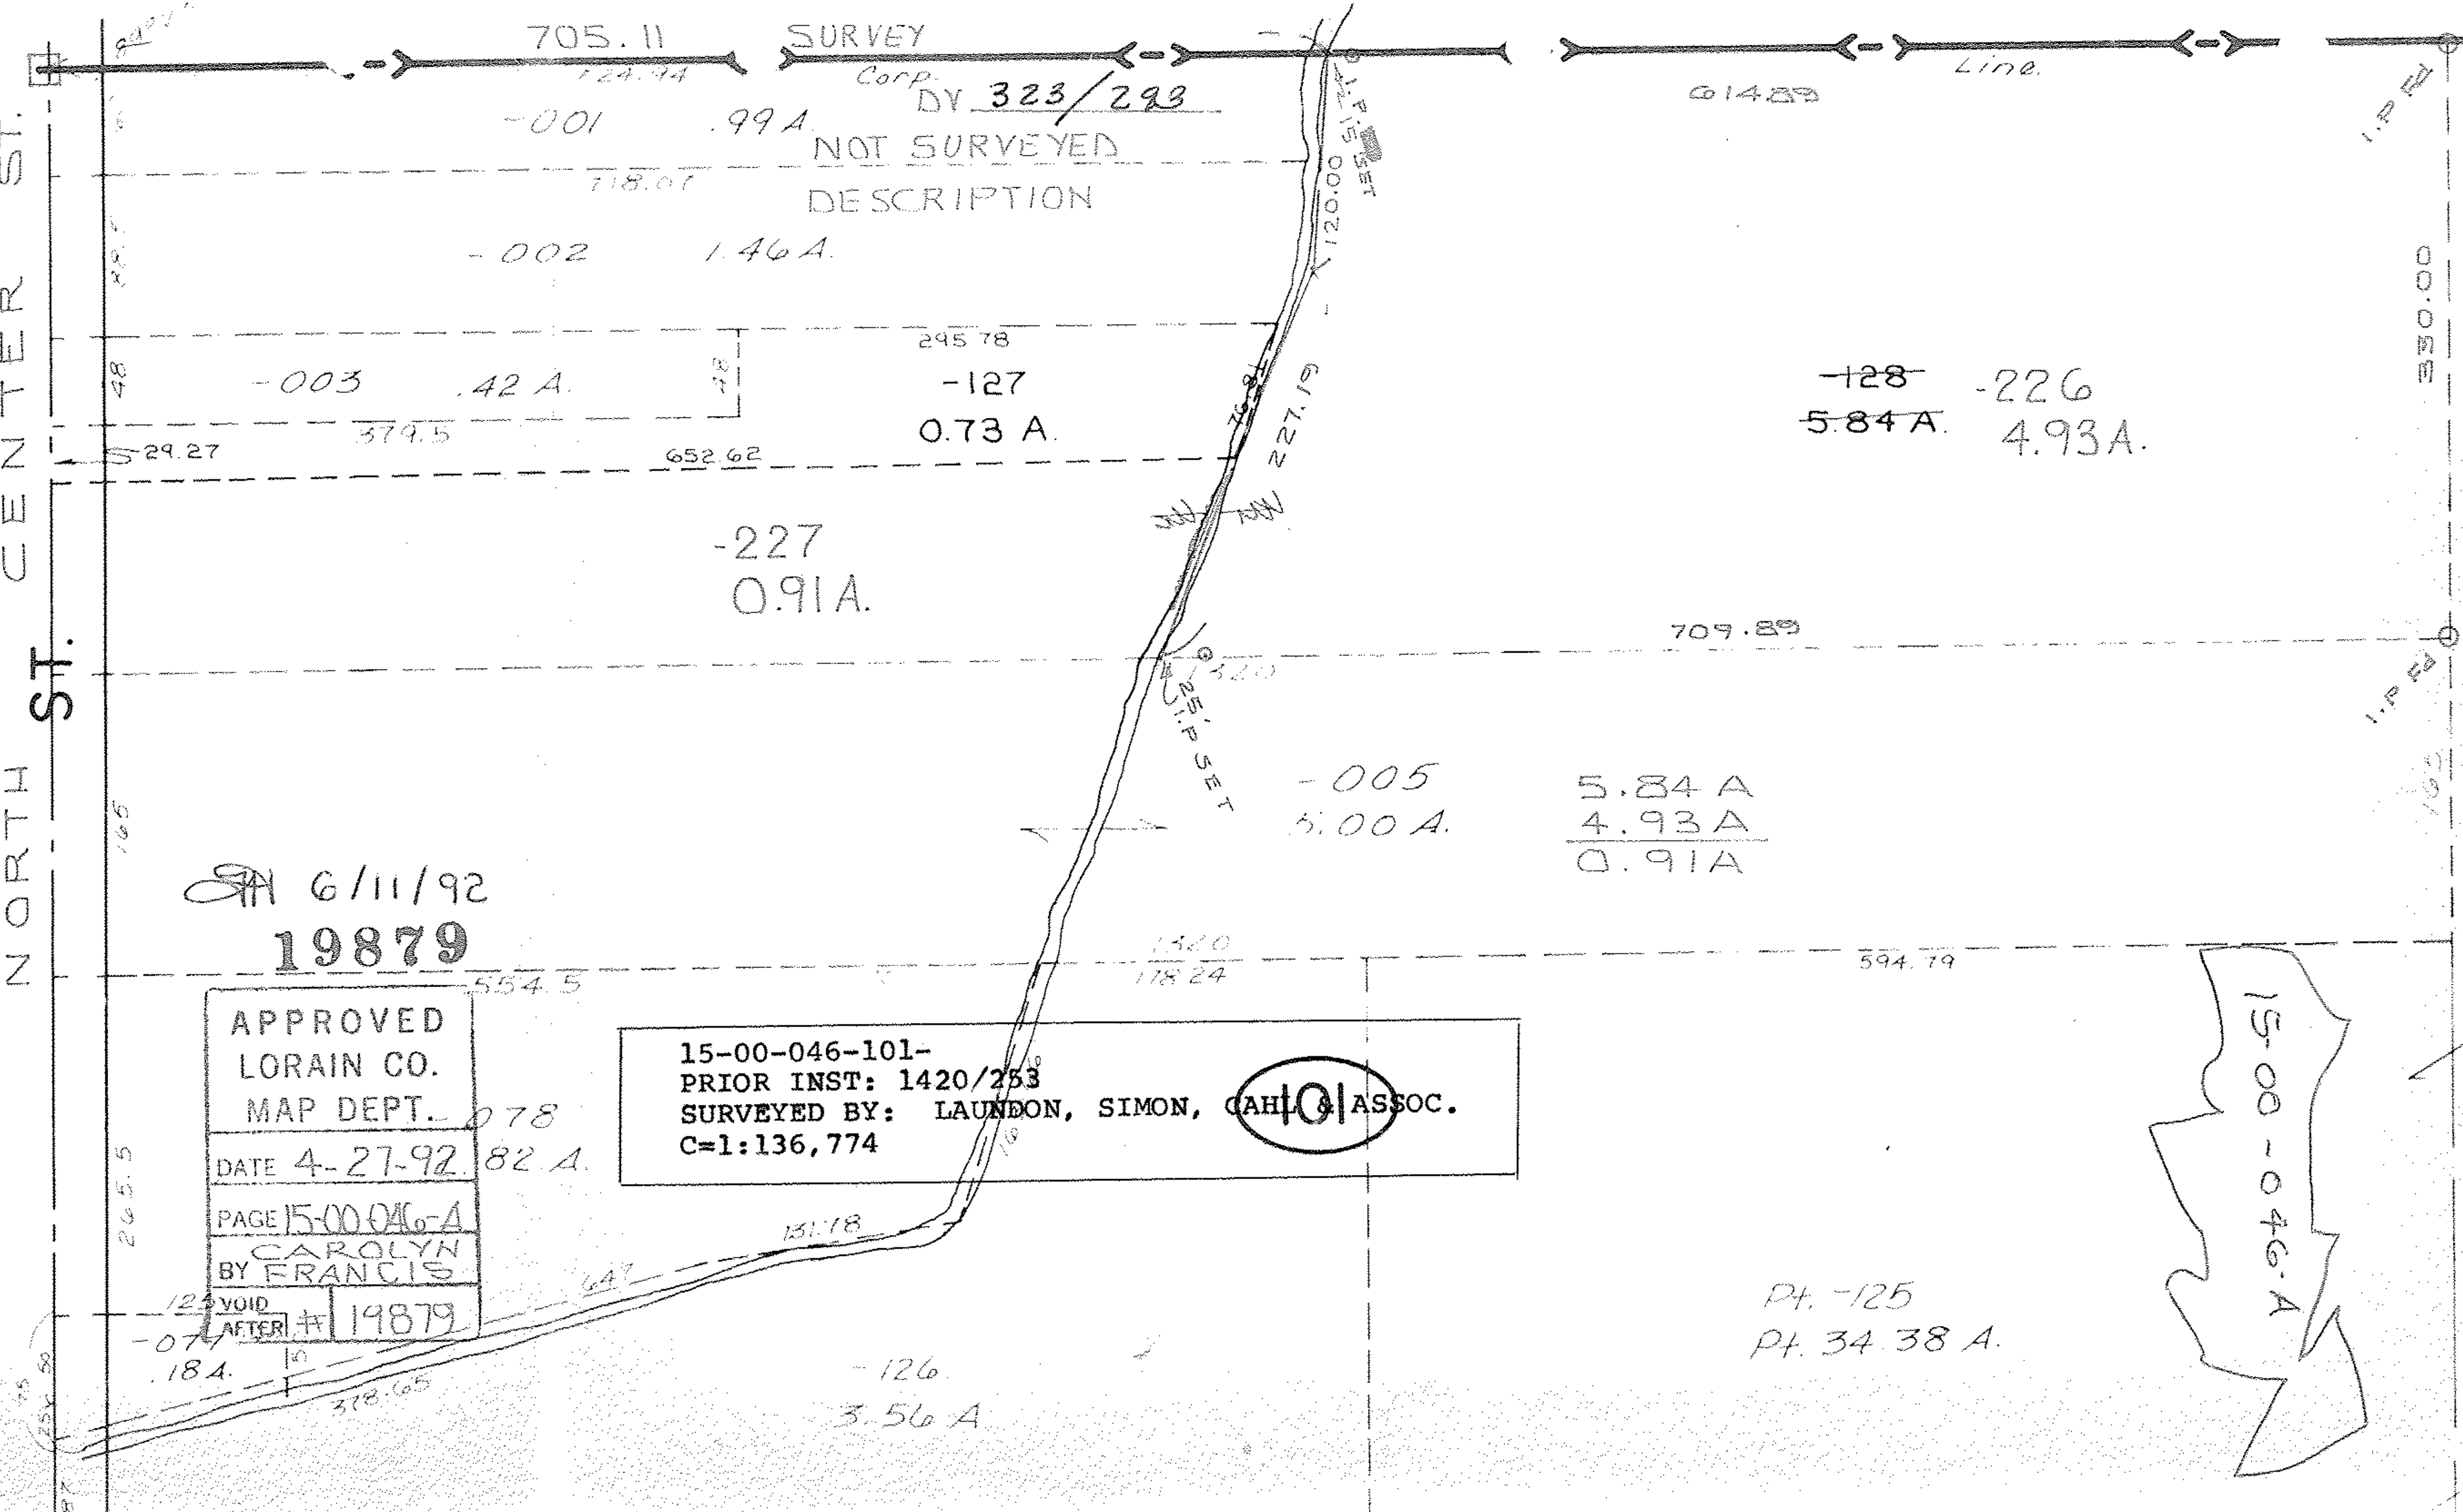

705.11

SURVEY

Corp. DY 323/293

614.89

Line.

-001

.99 A.

NOT SURVEYED

DESCRIPTION

718.07

-002

1.46 A.

295.78

-003

.42 A.

-127

0.73 A.

-128

-226

5.84 A.

4.93 A.

-227

0.91 A.

709.89

-005

5.84 A

5.00 A.

4.93 A

0.91 A

6/11/92
19879

APPROVED
LORAIN CO.
MAP DEPT.

DATE 4-27-92

PAGE 15-00-046-A

CAROLYN
BY FRANCIS

VOID
AFTER # 19879

15-00-046-101-
PRIOR INST: 1420/253
SURVEYED BY: LAUNDON, SIMON, CAHILL & ASSOC.
C=1:136,774

15-00-046-A

Pt. -125

Pt. 34.38 A.

-126

3.56 A

1.0000

1.0000

