


1989
1990
1991

APPROVED
LORAIN CO.
MAP DEPT.
 DATE 8-1-68
 BY *[Signature]*
 9/25/68 R.K.



WINDSOR

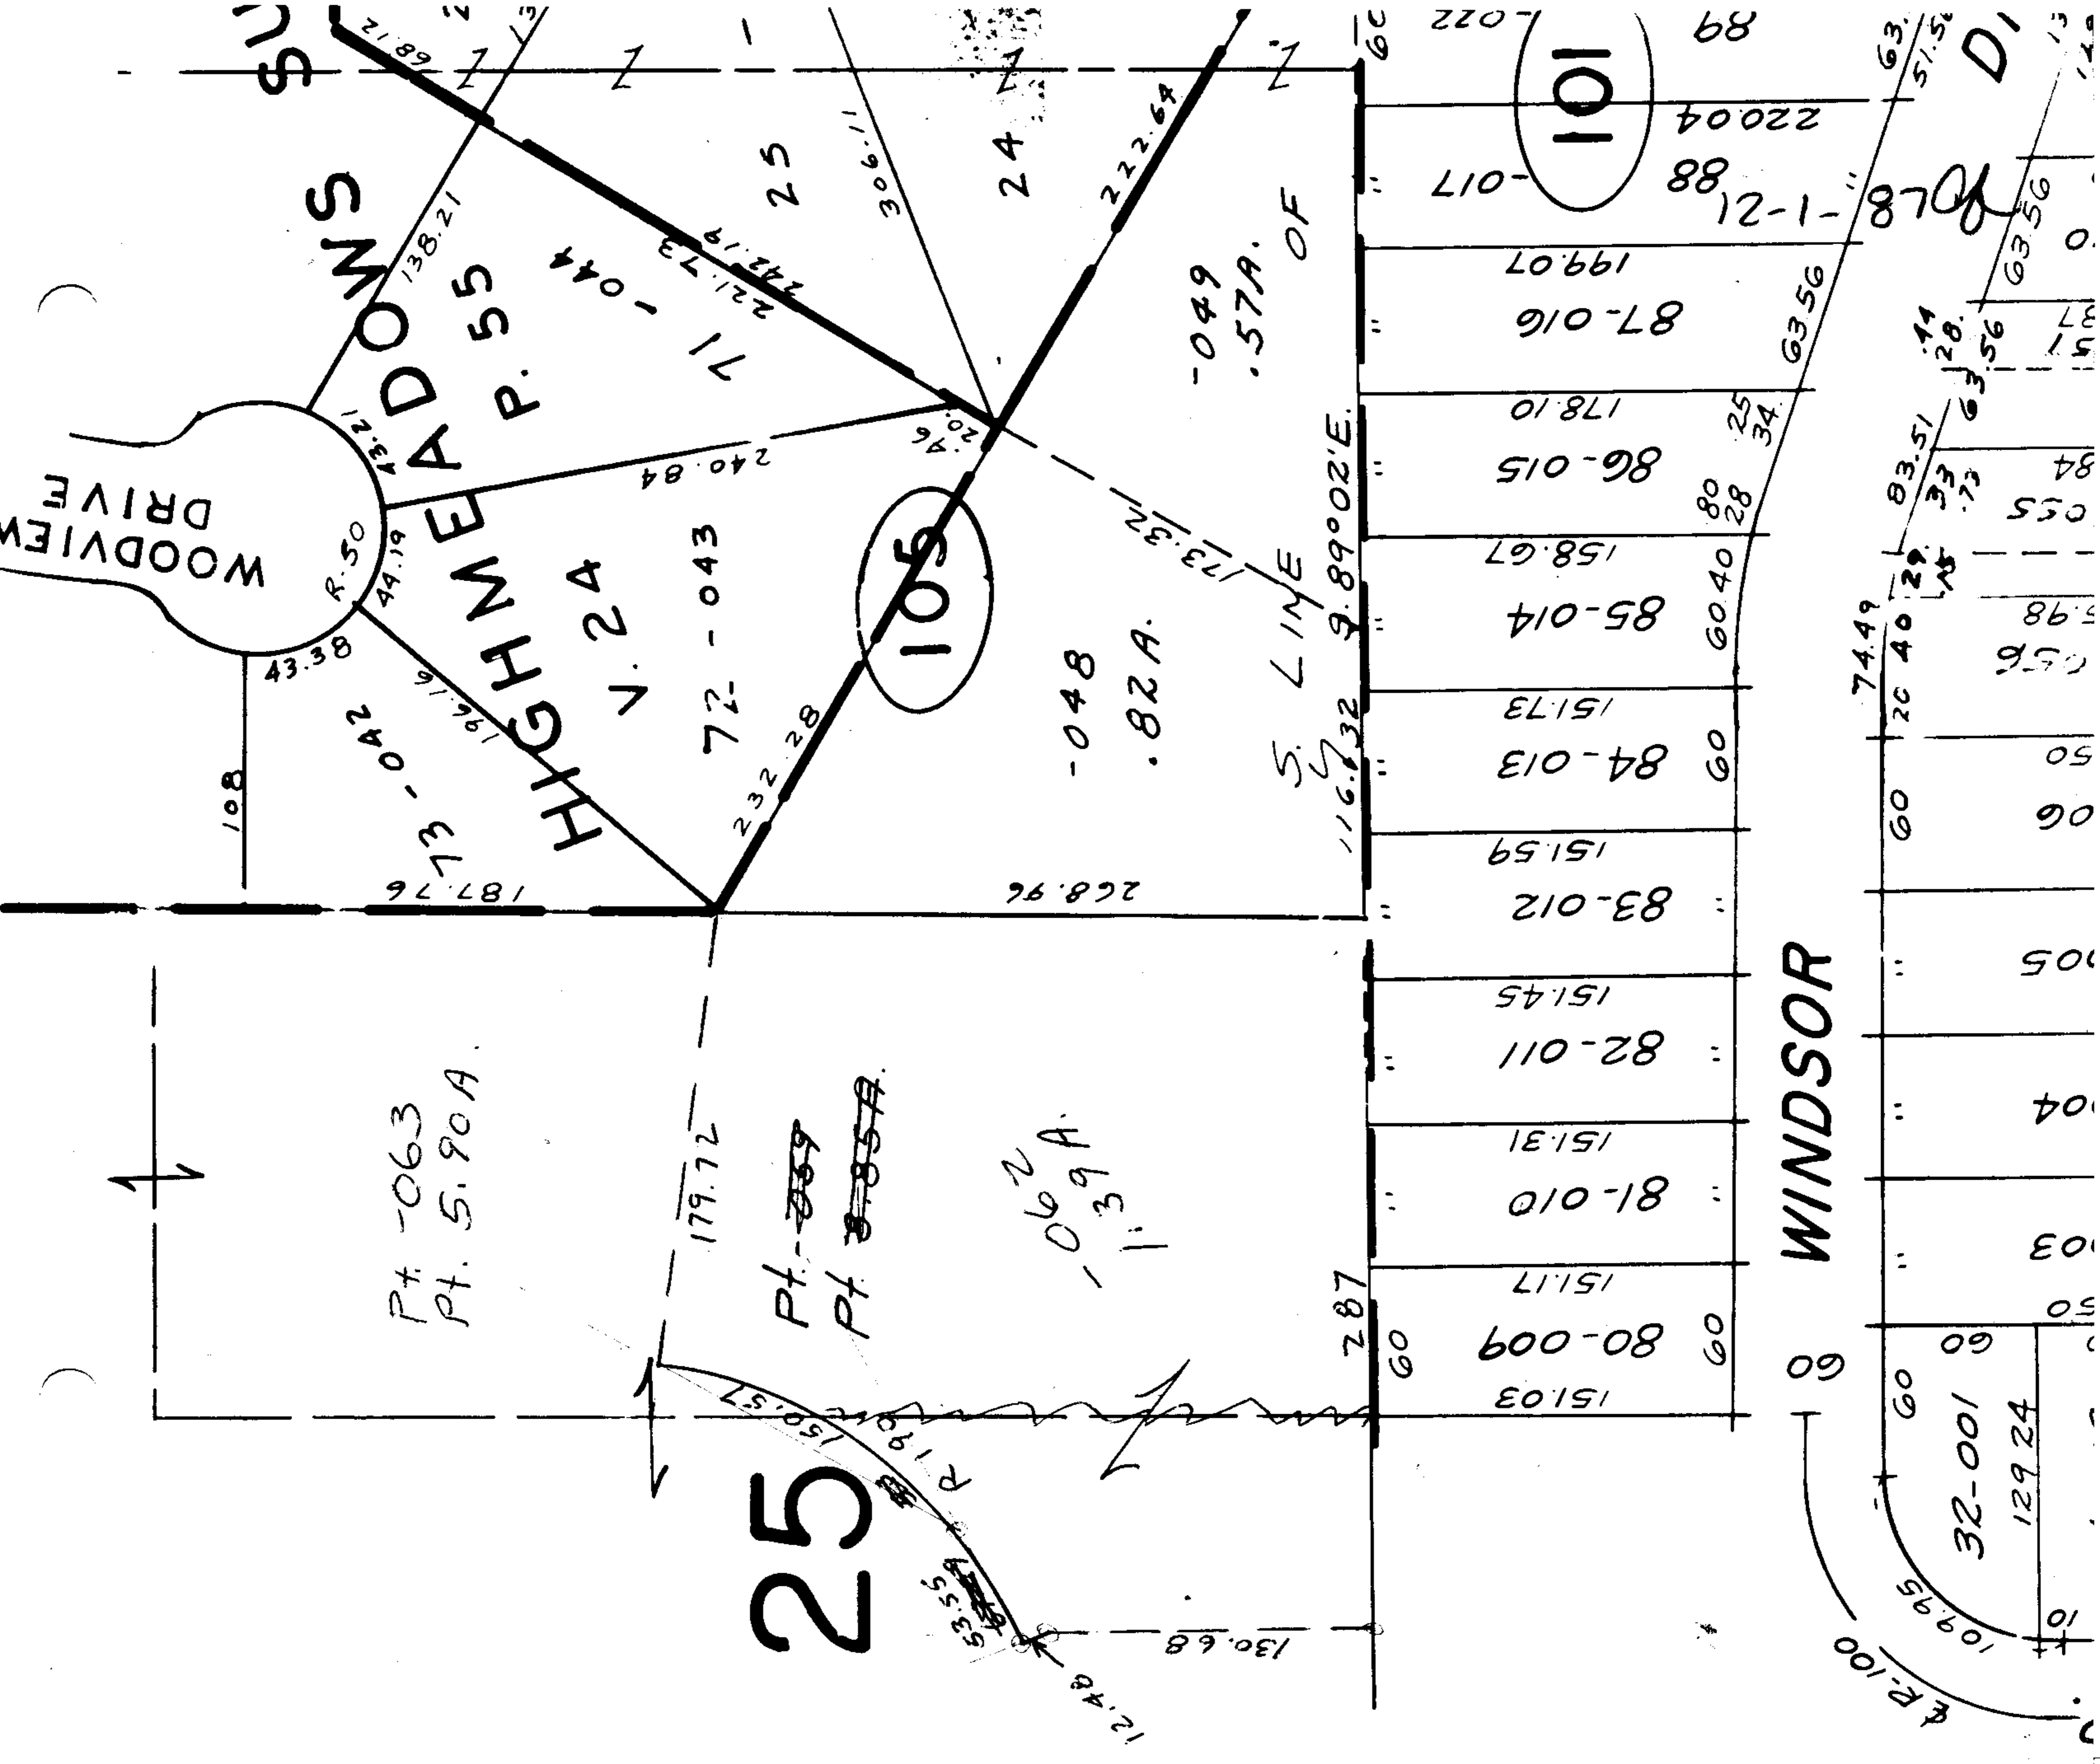