
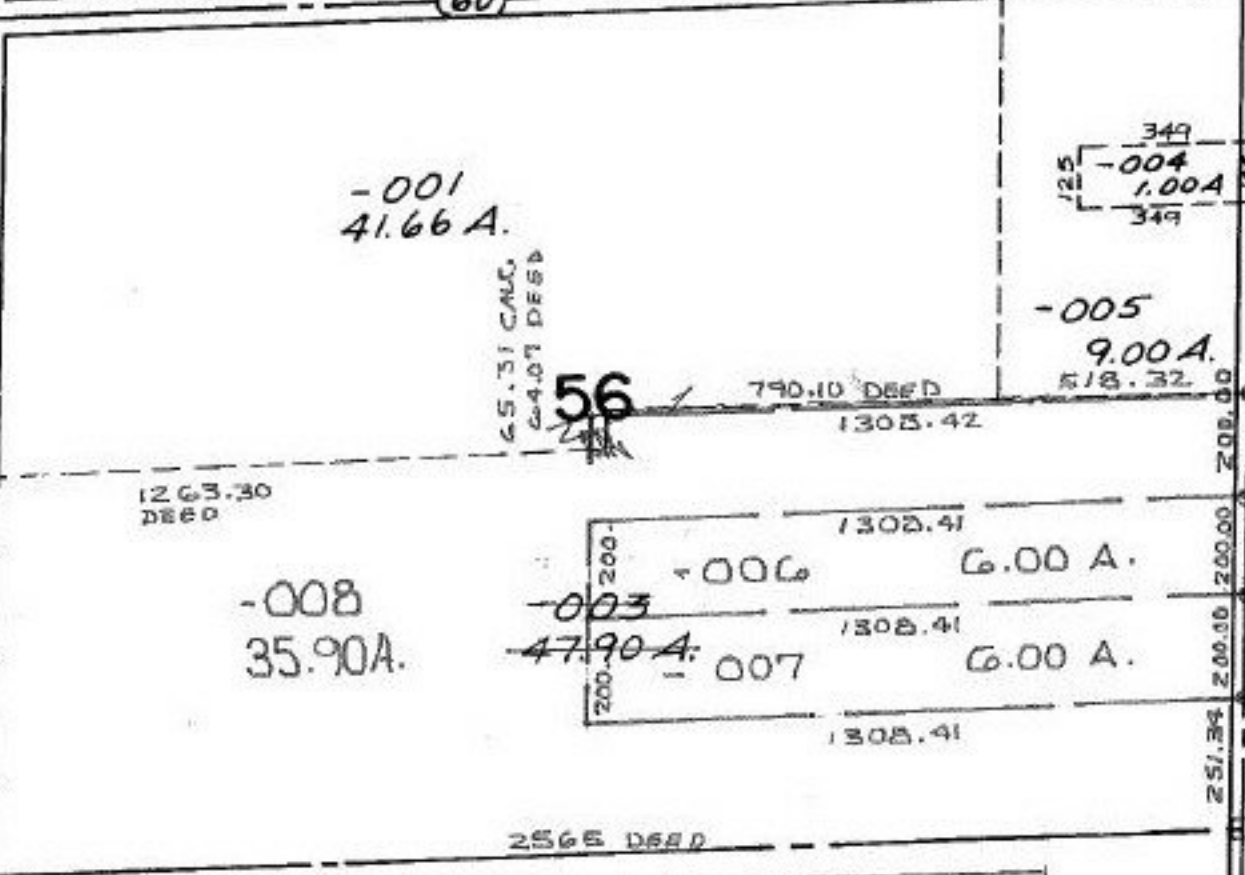


SEE 14-

ASHLAND-OBERLIN RD.

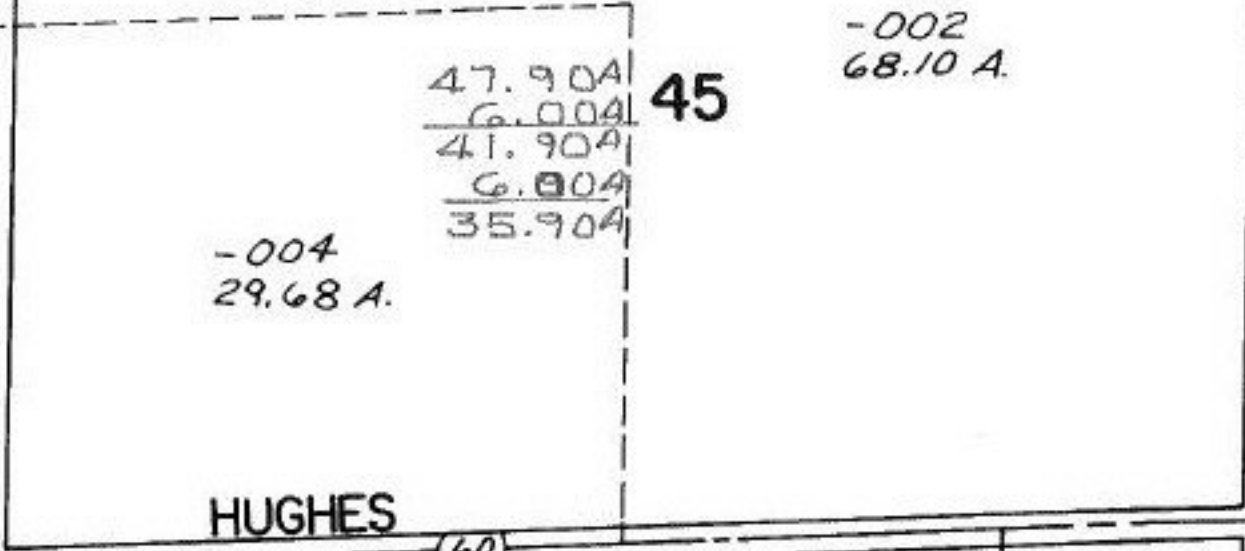

14-00-056-000- PRIOR INST: 1313/585
 SURVEYED BY: KS ASSOC. C=1: INF. C=1: INF.

6/11/92
 19900
 512
 -005 2.00 A
 512

65

-001
148.57 A.

APPROVED
 LORAIN CO.
 MAP DEPT.
 DATE 5-11-92
 PAGE 14-C
 BY CAROLYN
 FRANCIS
 VOID AFTER # 19900