


-008
153.97 A.

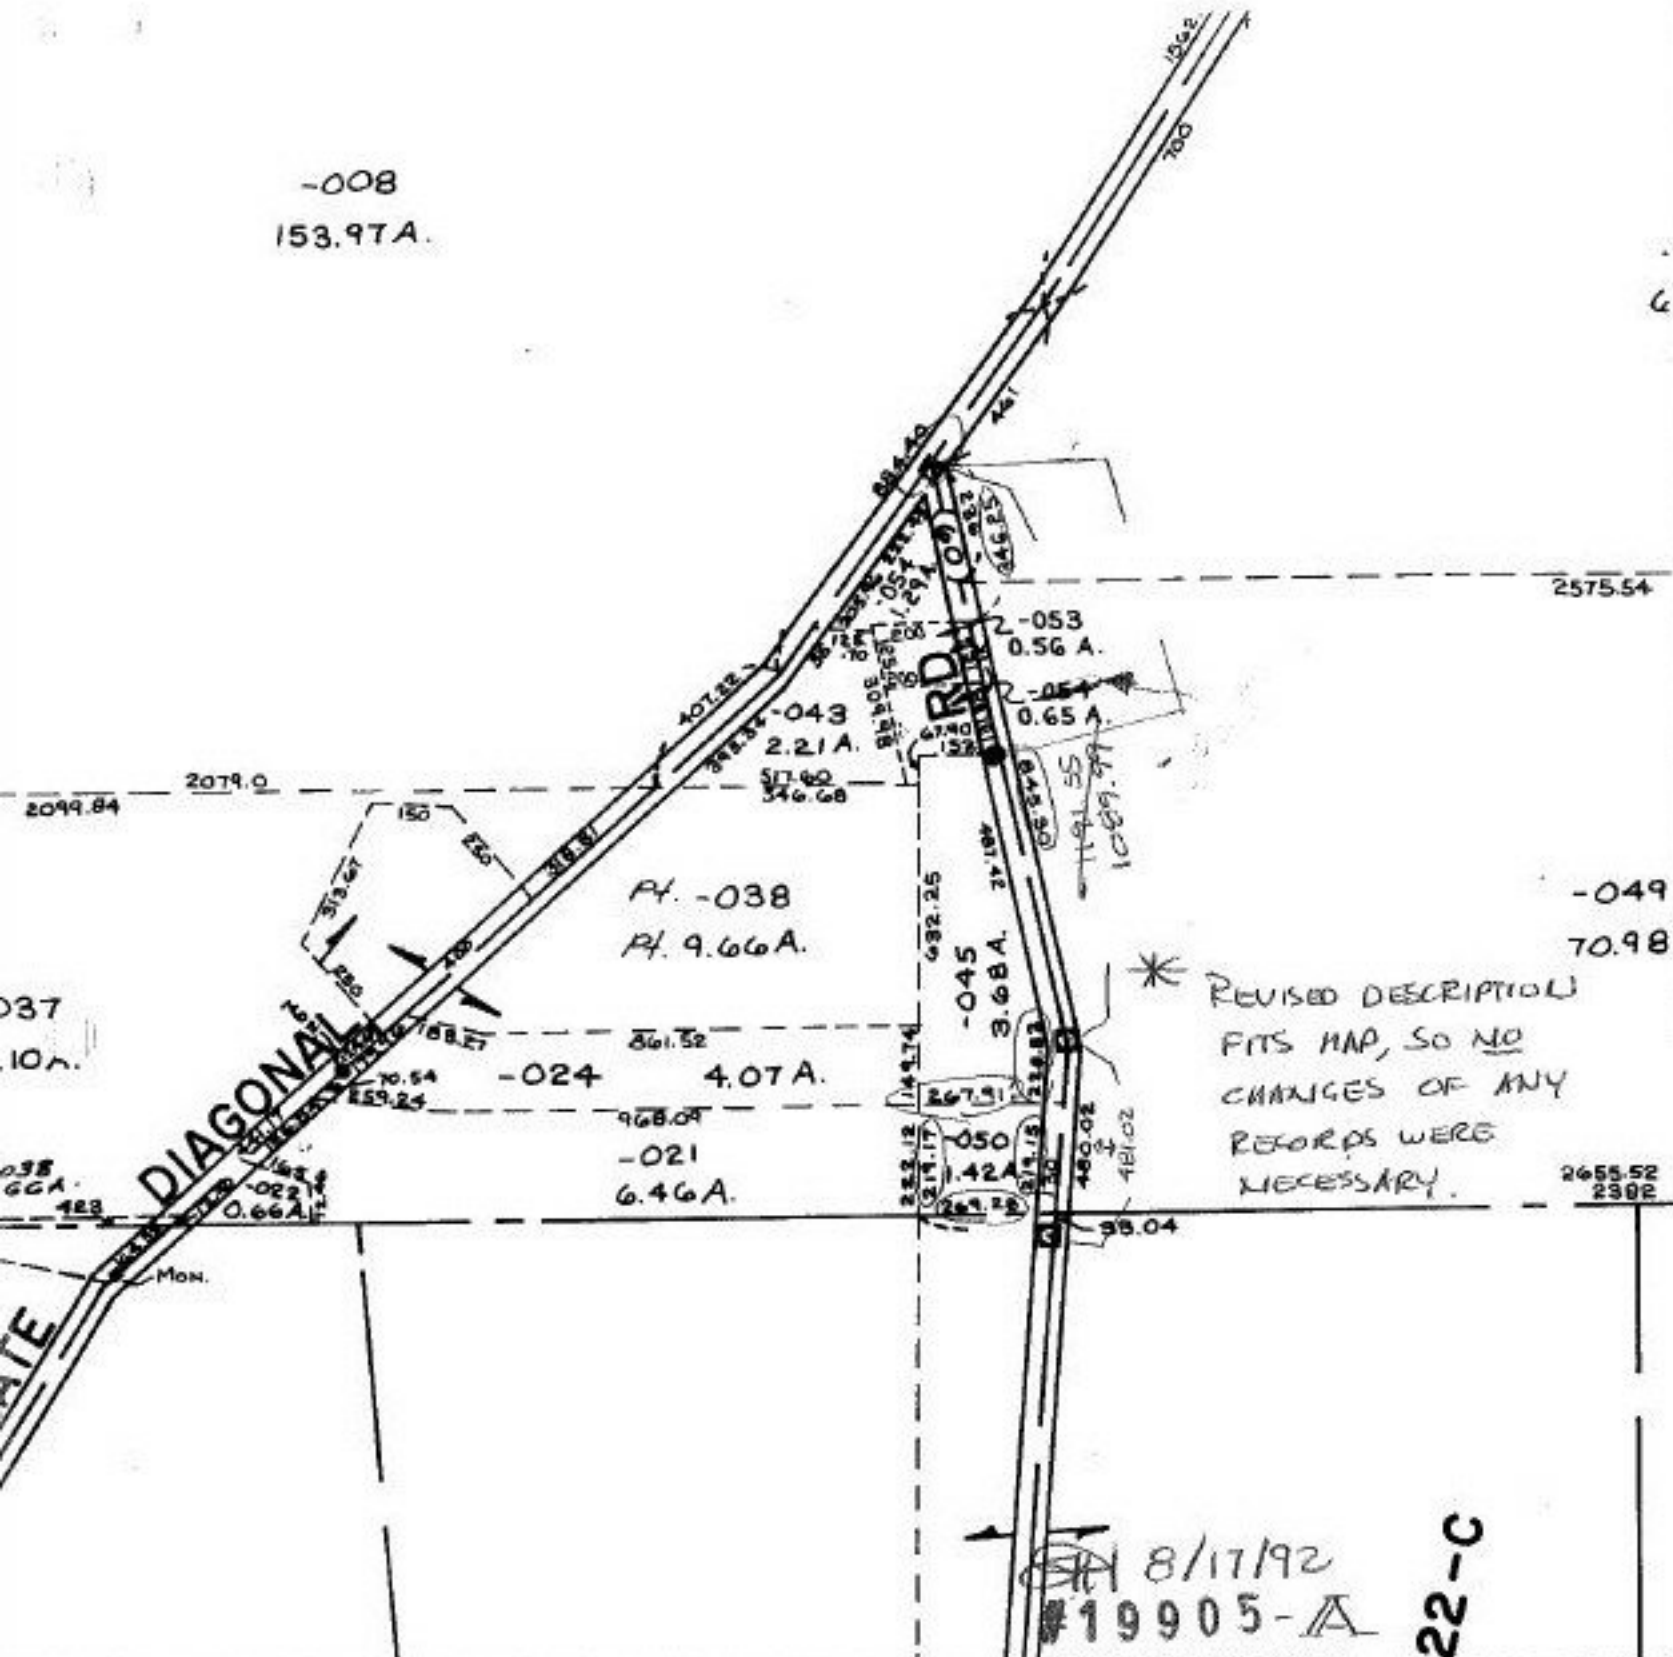

10-00-022-A

10-00-022-B

DEED CHECK

APPROVED
LORAIN CO.
MAP DEPT.
DATE 5/1/92
PAGE 10-F
BY T. McMain
VOID AFTER 19905-A

10-00-022-C

* REVISED DESCRIPTION FITS MAP, SO NO CHANGES OF ANY RECORDS WERE NECESSARY.

8/17/92
19905-A